

MISSISSIPPI DEPARTMENT OF NATURAL RESOURCES

Bureau of Land and Water Resources

Southport Mall

P.O. Box 10631

Jackson, Mississippi 39209

WATER WELL DRILLERS LOG

HANCOCK
J 35
3-13-85

Mar, 13 1985 Ward Well Dg. Hancock  
 date well completed firm name county well located

LANDOWNER: J. J. Cash  
 Neal St.  
 Bay St. Louis ms.  
 (mailing address)

WELL LOCATION:  
 ? sec. 28 T. 8 N. R. 18 E  
 6 miles N of Warland  
 (distance) (direction) (nearest town)

WELL PURPOSE: Home  
 (home, irrigation, municipal, industrial)

WELL COMPLETION DATA:

(1) diameter (inches) 2"  
 (2) total depth (feet) 178  
 (3) static water level (feet) 6 below top of ground.  
 (4) casing PVC, 168, (depth)  
 (size) if telescope see back.  
 (5) screen 10', (length) (depth to top)  
 2", PVC (size) (material)  
 (6) pump runner (HP) (yield gpm)  
 (type power)  
 (7) electric log NO (yes or no)  
 N/A (organization running log)  
 (8) how well bottom plugged BWV

description of formations encountered	from	to
Fill - clay	0	15
sd	15	47
clay	47	76
sd	76	85
clay-silt	85	105
sd	105	116
clay-silt	116	148
fine sd	148	167
coarse sd	167	178


RECEIVED  
 MAY 14 1985

DRILLERS REMARKS: -

Department of Natural Resources  
 Bureau of Land & Water Resources

If well telescopes please sketch and show depths.

GROUND LEVEL

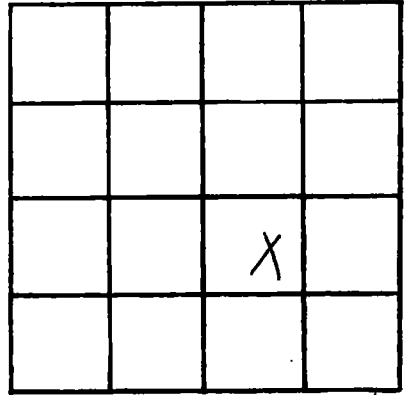

SECTION 28

Please indicate well location X.

ADDITIONAL INFORMATION

If more than one screen, show locations of each on sketch.