

HANCOCK

J 2002

5-6-66

MISSISSIPPI BOARD OF WATER COMMISSIONERS

WATER WELL DRILLERS LOG

Date: 5-6, 1966, Driller: Sutter Wood Water County Hancock

(When well drilled)

(Name)

(Where well is located)

(1) Owner of Land: W.S. Cole
(N.O.P.)
915 Fern St.
(Address)

Description & Color of Materials
Sand, Clay, Red Clay, Shell, etc.

Thick-ness Feet
Depth Feet

Clay
Sand

54 54
35 89

(2) Location: SW 1/4, NE 1/4, Sec. 1 T85R15W
3 miles SW of Kilmer
(distance) (direction) (Nearest Town)

(3) Topography: Hilly
(Hilly) (Flat) (Level)

(4) Purpose of Well: Domestic
(Domestic Irrigation
Municipal, Industrial, Other)

Information upon completion of well:

- (1) Diameter 2 inches.
(2) Total Depth 89 feet.
(3) Water Level 6 feet below top of ground.
(4) Cased to all, Size 2"
(5) Screen: Size 2", Length 5'
(6) Were any formations sealed against pollution?
yes, no.

If YES depth of formation surface


Why

Drillers Remarks:

Yield in gpm: 25

Size pump: Not known

Type power:

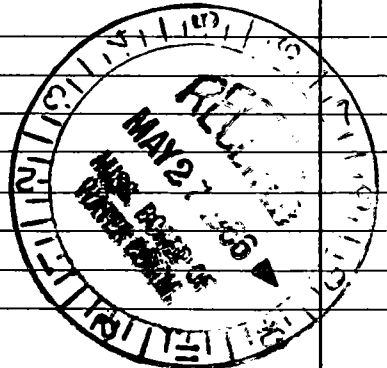

Handwritten notes at the top of the page, including the word "Handwritten" and other illegible scribbles.

Handwritten notes in the middle section of the page, appearing as faint scribbles.

Handwritten notes in the lower middle section of the page, including some faint numbers and symbols.

Handwritten notes at the bottom of the page, including some faint numbers and symbols.