

Hancock
 J 2004
 4-16-76

MISSISSIPPI
 BOARD OF WATER COMMISSIONERS
 416 North State Street
 Jackson, Mississippi 39201

WATER WELL DRILLERS LOG

Hancock

4-16-1976 Mc Hill Well Works Inc. Hancock
 date well completed firm name county well located


LANDOWNER: Robert Soupe
 2217 Lyndell
 Chalmette La.
 (milling address)

| description of formations encountered | from | to |
|---------------------------------------|------|-----|
| | Clay | 0 |
| Coarsel sand | 32 | 84 |
| Blue clay | 84 | 105 |
| Quartz sand | 105 | 140 |

WELL LOCATION: ~~XXXXXXXXXX~~
 sec. 34 T-9 N. R-10 E
 5 miles SW of Bay St. Louis
 (distance) (direction) (nearest town)

WELL PURPOSE: none
 (home, irrigation, municipal, industrial)

WELL COMPLETION DATA:
 (1) diameter (inches) 2"
 (2) total depth (feet) 140'
 (3) static water level (feet) _____ below top of ground.
 (4) casing 40 PVC 130'
 (material) (depth)
 _____ if telescope see back.
 (size)
 (5) screen 10' (length) (depth to top)
 2" (size) S.S. (material)
 (6) pump 1/2 (HP) 12 (yield gpm)
 Electric (type power)
 (7) electric log no (yes or no)
 _____ (organization running log)

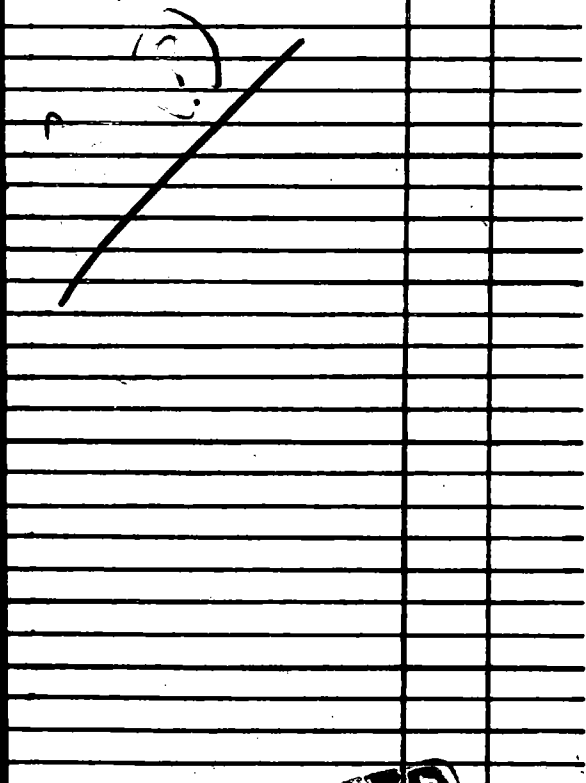

(8) how well bottom plugged Sand
 Shark

DRILLERS REMARKS:

RECEIVED

