

MISSISSIPPI
 BOARD OF WATER COMMISSIONERS
 416 North State Street
 Jackson, Mississippi 39201

WATER WELL DRILLERS LOG

Hancock
 J 2008
 11-17-79
 11-17-

1979 McGill Well works Hancock
 date well completed firm name county well located

LANDOWNER: Lloyd Lesker
 510 Bellamy St.
 Harvey, La.
 (mailing address)

WELL LOCATION: Bay St. Louis
 sec. 30 T. 12 N R. 15 E
 8 S 15 W
 7 miles NW of Greenwood
 (distance) (direction) (nearest town)

description of formations encountered	from to	
Clay	0	67
Sand	67	110
G. Clay	110	171
Sand	171	193
Slush	193	238
S. Sand	238	267
B. clay	267	318
C. Sand	318	350

WELL PURPOSE:
 (home, irrigation, municipal, industrial)


- WELL COMPLETION DATA:
- (1) diameter (inches) 2"
 - (2) total depth (feet) 350
 - (3) static water level (feet) 1' ^{below} _{above} top of ground.
 - (4) casing PVC, 340
 (material) (depth)
 - If telescope see back.
 (size)
 - (5) screen 10',
 (length) (depth to top)
 - 2", plastic
 (size) (material)
 - (6) pump 1, 12
 (HP) (yield gpm)
 - electric
 (type power)
 - (7) electric log no
 (yes or no)
 - (organization running log)
 - (8) how well bottom plugged back
wash valve

DRILLERS REMARKS:

DEPT. OF NATURAL RESOURCES
 BUREAU OF LAND & WATER RESOURCES
 MAY 2 1980
 RECEIVED

If well telescopes please sketch and show depths.

GROUND LEVEL

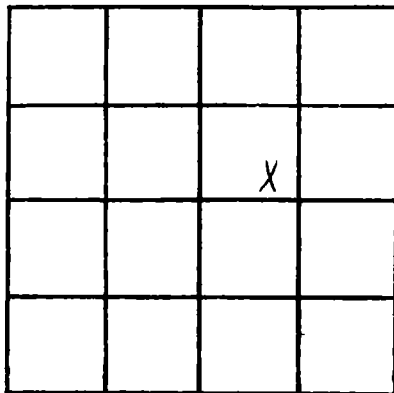

SECTION 30

Please indicate well location X.

ADDITIONAL INFORMATION

If more than one screen,
show locations of each on sketch.