

MISSISSIPPI DEPARTMENT OF NATURAL RESOURCES

Bureau of Land and Water Resources

Southport Mall

P.O. Box 10631

8

Jackson, Mississippi 39209

WATER WELL DRILLERS LOG *Harrison*

*Hancock*  
*J 2010*  
*8/5/80*

date well completed

firm name

county well located

*1980 Duncan Well Drilling, Hancock*

LANDOWNER:

description of formations encountered

from

to

*J.P. Peters*  
*6627 Golf Club Dr.*  
*Bay St. Louis, Ms.*  
(mailing address)

Clay	0	10
sand	10	40
white clay	40	118
Yin sand	118	150
Blue Clay	150	485
fine sand	485	507
Course Sand	507	525

WELL LOCATION:

sec. *3* T. *7* N. R. *13* E.  
*12* miles *N* of *Bay St. Louis*  
(distance) (direction) (nearest town)

WELL PURPOSE: *home*  
(home, irrigation, municipal, industrial)

WELL COMPLETION DATA:

- (1) diameter (inches) *2"*
- (2) total depth (feet) *525 ft*
- (3) static water level (feet) *70'* <sup>below</sup> above top of ground.
- (4) casing *PVC*, *51.5'*  
(material) (depth)
- (5) screen *10'*, *51.5'*  
(length) (depth to top)
- (6) pump *1*, *8*  
(HP) (yield gpm)
- electric*  
(type power)
- (7) electric log  (yes or no)

(organization running log)

(8) how well bottom plugged *sand*  
*dash*

DRILLERS REMARKS:


DEPT. OF NATURAL RESOURCES  
BUREAU OF LAND & WATER RESOURCES

MAR 18 1981

RECEIVED

If well telescopes please sketch and show depths.

GROUND LEVEL

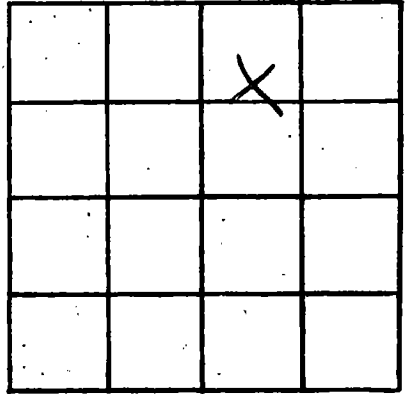

SECTION 3

Please indicate well location X.

ADDITIONAL INFORMATION

If more than one screen,  
show locations of each on sketch.