

**MISSISSIPPI DEPARTMENT OF NATURAL RESOURCES**  
**Bureau of Land and Water Resources**  
 Southport Mall  
 P.O. Box 10631  
 Jackson, Mississippi 39209  
**WATER WELL DRILLERS LOG**

Hancock  
4 J 2012

8-14 1980 Wood Well Dlg. Hancock  
 date well completed firm name county well located

LANDOWNER: Tom Branton  
Jaden River Dr.  
Box St. Louis, ms.  
 (mailing address)

WELL LOCATION:  
 sec. 22 T. 8 N. R. 14 E  
0 miles NE of B.S.L.  
 (distance) (direction) (nearest town)

WELL PURPOSE: Home  
 (home, irrigation, municipal, industrial)

**WELL COMPLETION DATA:**

- (1) diameter (inches) 2"
- (2) total depth (feet) 390
- (3) static water level (feet) 1 below above  
 top of ground.
- (4) casing PVC, 380  
 (material) (depth)  
— if telescope see back.  
 (size)
- (5) screen 10' —  
 (length) (depth to top)  
2" PVC  
 (size) (material)
- (6) pump 1/2 10  
 (HP) (yield gpm)  
Elec.  
 (type power)
- (7) electric log NO  
 (yes or no)  
N/A  
 (organization running log)
- (8) how well bottom plugged BWD


description of formations encountered	from	to
<u>Clay</u>	<u>0</u>	<u>26</u>
<u>sd</u>	<u>26</u>	<u>45</u>
<u>Fine sd</u>	<u>45</u>	<u>120</u>
<u>Clay - Silt</u>	<u>120</u>	<u>165</u>
<u>Fine sd</u>	<u>165</u>	<u>176</u>
<u>Clay - Silt</u>	<u>176</u>	<u>284</u>
<u>Fine sd</u>	<u>284</u>	<u>294</u>
<u>Clay - Silt</u>	<u>294</u>	<u>360</u>
<u>Fine sd</u>	<u>360</u>	<u>390</u>

DRILLERS REMARKS: Drilled to  
680 ft. - pulled back &  
produced at 390. - Fine  
sd.

DEPT. OF NATURAL RESOURCES  
 BUREAU OF LAND & WATER RESOURCES  
 SEP 10 1980  
**RECEIVED**

If well telescopes please sketch and show depths.

GROUND LEVEL

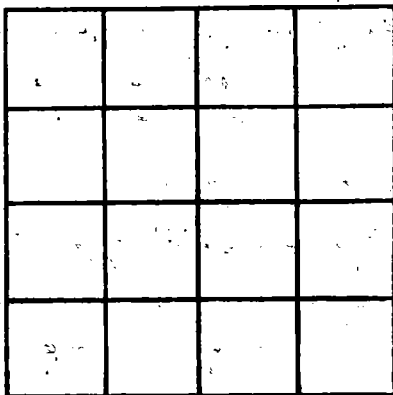

SECTION 22

Please indicate well location X.

ADDITIONAL INFORMATION

The sand from 360-390  
seemed to have some  
coarse streaks although  
most of our samples were  
mostly fine.

If more than one screen,  
show locations of each on sketch.