

MISSISSIPPI DEPARTMENT OF NATURAL RESOURCES

Bureau of Land and Water Resources

Southport Mall

P.O. Box 10631

Jackson, Mississippi 39209

WATER WELL DRILLERS LOG

Hancock  
Q 2014

12/16/81  
date well completed

19 Lipman Well Co.  
firm name

Hancock  
Harrison  
county well located

LANDOWNER: Nadine Bates

description of formations encountered

from

to

2603 W. David Dr.

Gpt, Md.  
(mailing address)

<u>Red sand gravel</u>	<u>0</u>	<u>100</u>
<u>Clay</u>	<u>120</u>	<u>210</u>
<u>Fine sand</u>	<u>210</u>	<u>260</u>
<u>Blue Clay</u>	<u>260</u>	<u>323</u>
<u>Medium Sand</u>	<u>323</u>	<u>360</u>

WELL LOCATION:

sec 32 T 8 N R 13 E  
15 miles N/W of Leveland  
(distance) (direction) (nearest town)

WELL PURPOSE: home  
(home, irrigation, municipal, industrial)

WELL COMPLETION DATA:

- (1) diameter (inches) 2"
- (2) total depth (feet) 360'
- (3) static water level (feet) 65 <sup>below</sup> <sub>above</sub> top of ground.
- (4) casing PVC, 350'  
(material) (depth)  
2"  
(size) if telescope see back.
- (5) screen 10', 350'  
(length) (depth to top)  
2", PVC  
(size) (material)
- (6) pump 1, 10  
(HP) (yield gpm)  
electric  
(type power)
- (7) electric log NO  
(yes or no)  
NO  
(organization running log)
- (8) how well bottom plugged sand  
Shark

DRILLERS REMARKS:


MISSISSIPPI DEPARTMENT OF NATURAL RESOURCES  
BUREAU OF LAND & WATER RESOURCES

APR 2 1982

RECEIVED

If well telescopes please sketch and show depths.

GROUND LEVEL

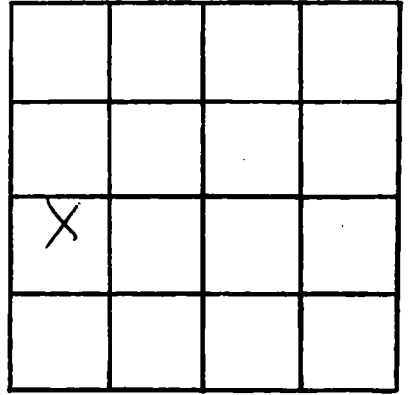

SECTION 32

Please indicate well location X.

ADDITIONAL INFORMATION

If more than one screen,  
show locations of each on sketch.