

MISSISSIPPI DEPARTMENT OF NATURAL RESOURCES

Bureau of Land and Water Resources

Southport Mall

P.O. Box 10631

Jackson, Mississippi 39209

WATER WELL DRILLERS LOG

*Hancock*  
 J-2018

1-6-1983 *Wood Well Dlg.* *Hancock*  
 date well completed firm name county well located

LANDOWNER	description of formations encountered	depth	
		from	to
<i>Lulu St.</i>	<i>fill - clay</i>	<i>0</i>	<i>17</i>
<i>Bay St. Louis mo.</i>	<i>sd</i>	<i>17</i>	<i>42</i>
(mailing address)	<i>clay</i>	<i>42</i>	<i>96</i>
	<i>coarse sd</i>	<i>96</i>	<i>113</i>

WELL LOCATION:  
 sec *29* T *8* N R *15* E  
*8* miles *N/W* of *Waveland*  
 (distance) (direction) (nearest town)

WELL PURPOSE: *home*  
 (home, irrigation, municipal, industrial)

- WELL COMPLETION DATA:
- (1) diameter (inches) *2"*
  - (2) total depth (feet) *113*
  - (3) static water level (feet) *2* *below* top of ground *above*
  - (4) casing *PVC* *103*  
 (material) (depth)  
 (size) If telescope see back.
  - (5) screen *10'* *-*  
 (length) (depth to top)  
*2"* *PVC*  
 (size) (material)
  - (6) pump *owner*  
 (HP) (yield gpm)  
 (type power)
  - (7) electric log *NO*  
 (yes or no)  
*N/A*  
 (organization running log)
  - (8) how well bottom plugged *BWU*

DEPT. OF NATURAL RESOURCES  
 BUREAU OF LAND & WATER RESOURCES


MAR - 4 1983

RECEIVED

DRILLERS REMARKS: *N/A*

If well telescopes please sketch and show depths.

GROUND LEVEL

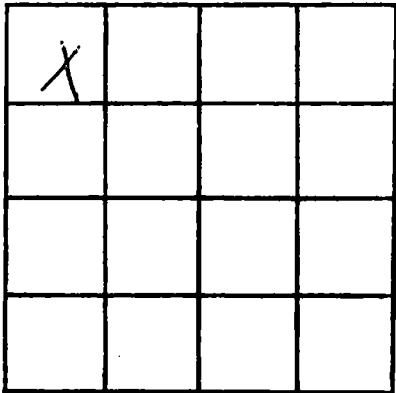

SECTION 29

Please indicate well location X.

ADDITIONAL INFORMATION

If more than one screen, show locations of each on sketch.