

MISSISSIPPI DEPARTMENT OF NATURAL RESOURCES

Bureau of Land and Water Resources

Southport Mall

P.O. Box 10631

Jackson, Mississippi 39209

WATER WELL DRILLERS LOG

Hancock
J 2019

1-17-1983 date well completed Wardwell Dlg firm name Hancock county well located

LANDOWNER: Earl Lindsey
Rt. 2, Box 792
Bay St. Louis, Miss.
 (mailing address)

description of formations encountered	from	to
	<u>fill - clay</u>	<u>0</u>
<u>clay</u>	<u>15</u>	<u>37</u>
<u>clay</u>	<u>37</u>	<u>92</u>
<u>cons. sd</u>	<u>92</u>	<u>108</u>

WELL LOCATION:
 sec 29 T 8 N R 15 E
8 miles (distance) N/W (direction) of B.S.L. (nearest town)

WELL PURPOSE: None
 (home, irrigation, municipal, industrial)

- WELL COMPLETION DATA:
- (1) diameter (inches) 2"
 - (2) total depth (feet) 108
 - (3) static water level (feet) 2 (below/above top of ground)
 - (4) casing PVC, 98 (material), (depth)
 (size) If telescope see back.
 - (5) screen 10' (length), (depth to top)
2" (size), PVC (material)
 - (6) pump Orville (HP), (yield gpm)
 (type power)
 - (7) electric log NO (yes or no)
N/A (organization running log)
 - (8) how well bottom plugged BWV

DEPT. OF NATURAL RESOURCES
 BUREAU OF LAND & WATER RESOURCES


MAR - 4 1983

RECEIVED

DRILLERS REMARKS: N/A

If well telescopes please sketch and show depths.

GROUND LEVEL

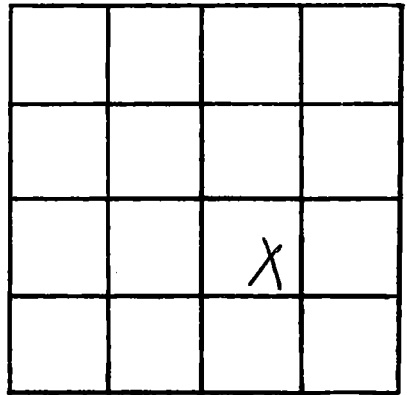

SECTION 29

Please indicate well location X.

ADDITIONAL INFORMATION

If more than one screen,
show locations of each on sketch.