

MISSISSIPPI DEPARTMENT OF NATURAL RESOURCES

Bureau of Land and Water Resources

Southport Mall

P.O. Box 10631

Jackson, Mississippi 39209

WATER WELL DRILLERS LOG

Hancock
J 2001

1-26
date well completed

1983 Ward Well Dlg.
firm name

Hancock
county well located

LANDOWNER: Bill Darter
Rt. 2, Box 842
Box St Louis, Mo.
(mailing address)

description of formations encountered

from	to
0	18
18	36
36	104
104	115
115	150
150	170

fill - clay
clay - silt
clay - silt
SD

WELL LOCATION:

sec 29 T 8 N R 13 E
7 miles NW of Wardland
(distance) (direction) (nearest town)

WELL PURPOSE: None
(home, irrigation, municipal, industrial)

WELL COMPLETION DATA:

- (1) diameter (inches) 2"
- (2) total depth (feet) 170
- (3) static water level (feet) 4' below above top of ground.
- (4) casing PVC, 160
(material) (depth)
(size) if telescope see back.
- (5) screen 10' -
(length) (depth to top)
2" PVC
(size) (material)
- (6) pump 1/2 10
(HP) (yield gpm)
elec
(type power)
- (7) electric log NO
(yes or no)
N/A
(organization running log)
- (8) how well bottom plugged BUW

DEPT OF NATURAL RESOURCES
BUREAU OF LAND & WATER RESOURCES


MAR - 4 1983

RECEIVED

DRILLERS REMARKS: N/A

If well telescopes please sketch and show depths.

GROUND LEVEL

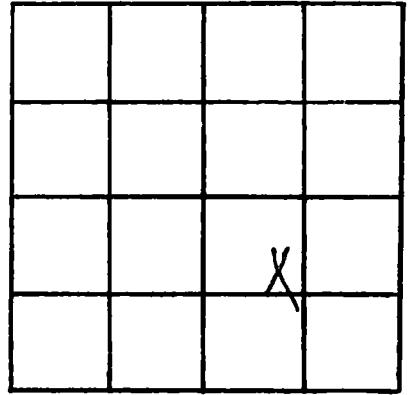

SECTION _____

Please indicate well location X.

ADDITIONAL INFORMATION

If more than one screen, show locations of each on sketch.