

MISSISSIPPI DEPARTMENT OF NATURAL RESOURCES

Bureau of Land and Water Resources

Southport Mall

P.O. Box 10631

Jackson, Mississippi 39209

WATER WELL DRILLERS LOG

Hancock  
J 203

2-8-1983 Ward Well Dr. Hancock  
date well completed firm name county well located

LANDOWNER:	description of formations encountered	from	to
<u>Munro Spivey</u>	<u>Fill-clay</u>	<u>0</u>	<u>21</u>
<u>River Rd</u>	<u>Sd</u>	<u>21</u>	<u>44</u>
<u>Bay St, Louis ms.</u> (mailing address)	<u>clay</u>	<u>44</u>	<u>76</u>
WELL LOCATION:	<u>Sd</u>	<u>56</u>	<u>82</u>
sec. <u>22</u> T <u>8</u> N R <u>13</u> E	<u>clay</u>	<u>82</u>	<u>102</u>
<u>8</u> miles <u>N/W</u> of <u>B.S.L.</u>	<u>fine Sd</u>	<u>102</u>	<u>124</u>
(distance) (direction) (nearest town)	<u>clay</u>	<u>124</u>	<u>136</u>
WELL PURPOSE: <u>drinking</u> (home, irrigation, municipal, industrial)	<u>Sd</u>	<u>136</u>	<u>150</u>
WELL COMPLETION DATA:			
(1) diameter (inches) <u>2"</u>			
(2) total depth (feet) <u>150</u>			
(3) static water level (feet) <u>4</u> <u>below</u> top of ground.			
(4) casing <u>PVC</u> , <u>140</u> (material) (depth)			
<u>-</u> If telescope see back. (size)			
(5) screen <u>10'</u> , <u>-</u> (length) (depth to top)			
<u>2"</u> , <u>PVC</u> (size) (material)			
(6) pump <u>owner</u> , <u>-</u> (HP) (yield gpm)			
<u>-</u> (type power)			
(7) electric log <u>NO</u> (yes or no)			
<u>N/A</u> (organization running log)			
(8) how well bottom plugged <u>DNW</u>			

DEPT. OF NATURAL RESOURCES  
BUREAU OF LAND & WATER RESOURCES


MAR 21 1983

RECEIVED

DRILLERS REMARKS:

If well telescopes please sketch and show depths.

GROUND LEVEL

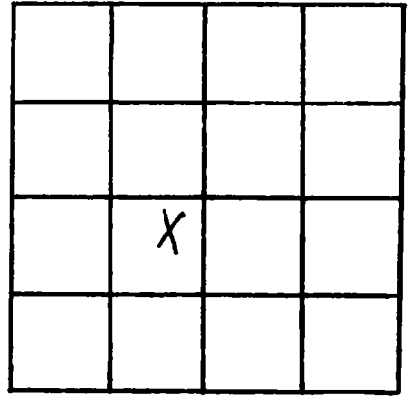

SECTION 8

Please indicate well location X.

ADDITIONAL INFORMATION

If more than one screen,  
show locations of each on sketch.