

MISSISSIPPI DEPARTMENT OF NATURAL RESOURCES
Bureau of Land and Water Resources
 Southport Mall
 P.O. Box 10631
 Jackson, Mississippi 39209
WATER WELL DRILLERS LOG

Hancock
5 2085

M-L 1983 Mr. Lee Wood Wells Hancock
 date well completed firm name county well located

LANDOWNER: David Maffray
P.O. Box 501
Kiln, MS 39556
 (mailing address)

WELL LOCATION:
 sec. 8 T7 N R. 15 E
7 miles S.W. of Kiln
 (distance) (direction) (nearest town)

WELL PURPOSE: Home
 (home, irrigation, municipal, industrial)

WELL COMPLETION DATA:
 (1) diameter (inches) 2"
 (2) total depth (feet) 400'
 (3) static water level (feet) 60 below top of ground
 (4) casing Sch 40 pipe, 390' (material) (depth)
 (size) if telescope see back.
 (5) screen 10', 390' (length) (depth to top)
 2", Sch 80 (size) (material)
 (6) pump 1 (HP) 10 (yield gpm)
 electric (type power)
 (7) electric log - (yes or no)
 (organization running log)
 (8) how well bottom plugged Seal

description of formations encountered	depth	
	from	to
Clud	0	40
Sand	40	60
Sand	60	80
Clud	80	200
Sand	200	210
Clud	210	300
Sand	300	330
Clud	330	360
Sand	360	380
Sand	380	400

DEPT. OF NATURAL RESOURCES
 BUREAU OF LAND & WATER RESOURCES


JAN 16 1984

RECEIVED

DRILLERS REMARKS:

If well telescopes please sketch and show depths.

GROUND LEVEL

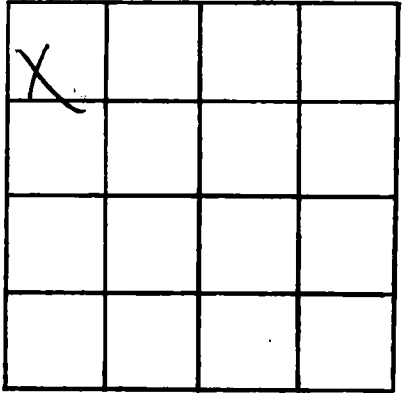

X			

SECTION 8

Please indicate well location X.

ADDITIONAL INFORMATION

If more than one screen, show locations of each on sketch.