

MISSISSIPPI DEPARTMENT OF NATURAL RESOURCES
Bureau of Land and Water Resources
 Southport Mall
 P.O. Box 10631
 Jackson, Mississippi 39209
WATER WELL DRILLERS LOG

Hancock
J 2006

1-24 1984 McGill Wells, INC. HANCOCK
 date well completed firm name county well located

LANDOWNER: JERRY LEFANT
301 Piney Ridge Road
WAUVELAND, MS
 (mailing address)

description of formations encountered	from	to
	<u>course sand</u>	<u>0</u>

WELL LOCATION:
 sec. 30 T 9 N R. 15 E
6 miles W of Bay St. Louis
 (distance) (direction) (nearest town)

WELL PURPOSE: irrigation
 (home, irrigation, municipal, industrial)

WELL COMPLETION DATA:

(1) diameter (inches) 2"

(2) total depth (feet) 20'

(3) static water level (feet) 2' below above top of ground.

(4) casing Sch. 40 PVC 10'
 (material) (depth)
 (size) if telescope see back.

(5) screen 10' 10'
 (length) (depth to top)
2" (size) Sch. 40 PVC (material)

(6) pump 1/2 15
 (HP) (yield gpm)
Electric (type power)

(7) electric log ---
 (yes or no)
 (organization running log)

(8) how well bottom plugged capped.

DRILLERS REMARKS:


DEPT. OF NATURAL RESOURCES
 BUREAU OF LAND & WATER RESOURCES

FEB - 3 1984

RECEIVED

If well telescopes please sketch and show depths.

GROUND LEVEL

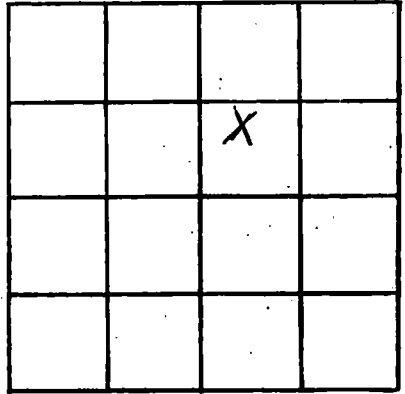

SECTION 30

Please indicate well location X.

ADDITIONAL INFORMATION

If more than one screen, show locations of each on sketch.