

MISSISSIPPI DEPARTMENT OF NATURAL RESOURCES

Bureau of Land and Water Resources

Southport Mall

P.O. Box 10631

Jackson, Mississippi 39209

WATER WELL DRILLERS LOG

HANCOCK
J 2029
3-26-81

3-26-19 81 Wood Well Dly. Hancock
 date well completed firm name county well located

LANDOWNER: James C. Matthews
Bonita Circle
Boy St. Louis, ms.
 (mailing address)

description of formations encountered	from	to
Clay	0	22
sd	22	46
Clay	46	95
Fine sd	95	115
Clay - silt	115	147
silt - sd	147	168
med. coarse sd	168	180

WELL LOCATION:
 sec. 27 T-8 N 5 R-13 E
8 miles N/W of B.S.L.
 (distance) (direction) (nearest town)

WELL PURPOSE: Home
 (home, irrigation, municipal, industrial)

WELL COMPLETION DATA:

(1) diameter (inches) 2"

(2) total depth (feet) 180

(3) static water level (feet) 4 below top of ground. above

(4) casing PVC 170
 (material) (depth)

- If telescope see back.
 (size)

(5) screen 10' -
 (length) (depth to top)

2" PVC
 (size) (material)

(6) pump 1/2 10
 (HP) (yield gpm)

elec.
 (type power)

(7) electric log NO
 (yes or no)

N/A
 (organization running log)

(8) how well bottom plugged BWV

DRILLERS REMARKS: N/A


DEPT. OF NATURAL RESOURCES
 BUREAU OF LAND & WATER RESOURCES

APR 29 1981

RECEIVED

If well telescopes please sketch and show depths.

GROUND LEVEL

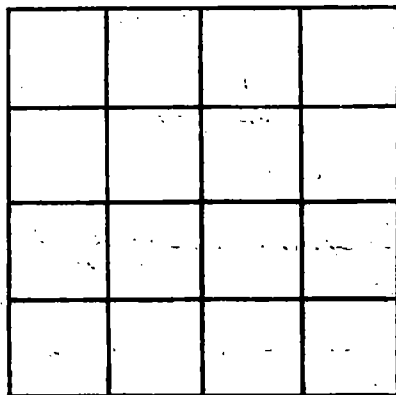

SECTION 27

Please indicate well location X.

ADDITIONAL INFORMATION

If more than one screen, show locations of each on sketch.