

MISSISSIPPI DEPARTMENT OF NATURAL RESOURCES

Bureau of Land and Water Resources

Southport Mall

P.O. Box 10631

Jackson, Mississippi 39209

WATER WELL DRILLERS LOG

Heacock
8 2031

11-25 1992 Wood Well Dr. Itanook
date well completed firm name county well located

LANDOWNER William Holden
Shark St
Bay St. Louis, Miss.
(mailing address)

description of formations encountered	from	to
<u>fill - clay</u>	<u>0</u>	<u>15</u>
<u>sd</u>	<u>15</u>	<u>45</u>
<u>clay - silt</u>	<u>45</u>	<u>106</u>
<u>fine sd</u>	<u>106</u>	<u>121</u>
<u>clay - silt</u>	<u>121</u>	<u>145</u>
<u>coarse sd</u>	<u>145</u>	<u>165</u>

WELL LOCATION:
sec 28 T 8 N R 14 E
10 miles N/W of Waveland
(distance) (direction) (nearest town)

WELL PURPOSE: camp
(home, irrigation, municipal, industrial)

- WELL COMPLETION DATA:
- (1) diameter (inches) 2"
 - (2) total depth (feet) 165
 - (3) static water level (feet) 4 ^{clay} above top of ground.
 - (4) casing PVC 155
(material) (depth)
 - if telescope see back.
(size)
 - (5) screen 10' -
(length) (depth to top)
 - 2" PVC
(size) (material)
 - (6) pump owner
(HP) (yield gpm)
 - (type power)
 - (7) electric log NO
(yes or no)
 - N/A
(organization running log)
 - (8) how well bottom plugged BWV

DEPT. OF NATURAL RESOURCES
BUREAU OF LAND & WATER RESOURCES


JAN - 7 1993

RECEIVED

DRILLERS REMARKS: locked in shoreline post.

If well telescopes please sketch and show depths.

GROUND LEVEL

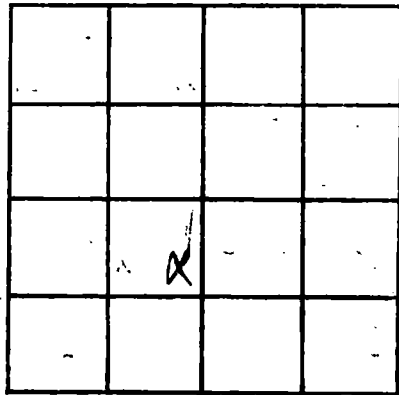

SECTION 28

Please indicate well location X.

ADDITIONAL INFORMATION

If more than one screen, show locations of each on sketch.