

MISSISSIPPI DEPARTMENT OF NATURAL RESOURCES

Bureau of Land and Water Resources

Southport Mall

P.O. Box 10631

Jackson, Mississippi 39209

WATER WELL DRILLERS LOG

Hancock
82032

2-3-

1983

Ward Well Drilling

Hancock

date well completed

firm name

county well located

LANDOWNER: Wynn Engrs.

description of formations encountered

from

to

Central ave

fill - clay

0 15

Bay St. Louis Mrs.
(mailing address)

sd
clay

15 38

38 95

WELL LOCATION:

sec 28 T 8 N R 14 E

9 miles N/IV of WAVELAND
(distance) (direction) (nearest town)

clay
sd

95 112

112 132

132 150

WELL PURPOSE: Comp
(home, irrigation, municipal, industrial)

WELL COMPLETION DATA:

(1) diameter (inches) 2"
(2) total depth (feet) 150'
(3) static water level (feet) 4 below above top of ground.

(4) casing PVC 140
(material) (depth)

(size) If telescope see back.

(5) screen 10' -
(length) (depth to top)

2" PVC
(size) (material)

(6) pump 1/2 10
(HP) (yield gpm)

Elec.
(type power)

(7) electric log NO
(yes or no)

N/A
(organization running log)

(8) how well bottom plugged BWU

DEPT. OF NATURAL RESOURCES
BUREAU OF LAND & WATER RESOURCES


MAR 21 1983

DRILLERS REMARKS: N/A

RECEIVED

If well telescopes please sketch and show depths.

GROUND LEVEL

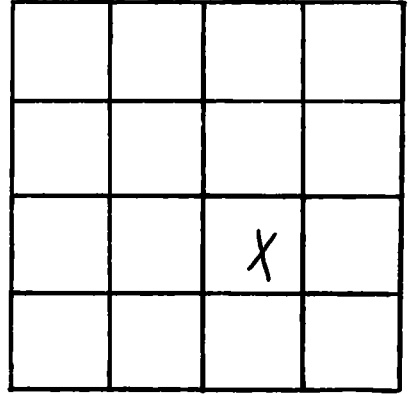

SECTION 28

Please indicate well location X.

ADDITIONAL INFORMATION

If more than one screen,
show locations of each on sketch.