

K2
9-5-63

WATER WELL DRILLERS LOG E LOG #30

Date: 9-5, 1963, Driller: C. T. SWITZER WELLS, (Name) **CODED**

(1) Owner of Land: City of Woodland
(Name)
Side St. Woodland
(Address)

(2) Location: 10 19 R14
_____ miles _____ of _____
(distance) (direction) (Nearest Town)

(3) Topography: _____
(Hilly) (Flat) (Level)

(4) Purpose of Well: Municipal
(Domestic Irrigation
Municipal, Industrial, Other)

Description & Color of Materials Sand, Clay, Red Clay, Shell, etc.	Thick- ness Feet
clay	00-11
sand	11-19
clay	19-32
sand	32-42
clay	42-102
sand	102-125
clay	125-135
clay & sand shls	135-157
clay	157-169
sand & gravel	169-186
clay	186-219
sand	219-239
clay	239-246
shells	246-270
clay	270-273
shells	273-333
shells & sand shls	333-379
clay	379-421
sand	421-434
shells & gravel	434-442
shells	442-458
sand, fine	458-495
clay	495-544
clay w/ sand shls	544-553
sand	553-574
clay	574-584
shells & sand shls	584-619
shells & sand shls	619-629
sand	629-706
sand	706-718
clay	718-729
shells	729-734

Information upon completion of well:

(1) Diameter: 12 1/2 inches.

(2) Total Depth: 1000 feet.

(3) Water Level: 111' feet below top of ground.

(4) Cased to: 1000', Size: 12 1/2"

(5) Screen: Size 8", Length 60'


(6) Were any formations sealed against pollution?
 yes, _____ no.

If YES depth of formation _____

Why: Health Dept. requirement

Drillers Remarks: _____

CODED

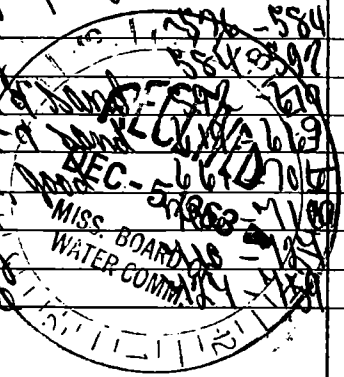

(Use Back Side)

812-100 @

854-812

854-812

812-812

811-812

803-811

811-803

459-1119

Hand
Hand & Hand

Hand
Hand
Hand / for

Hand
Hand
Hand