

HANCOCK

MISSISSIPPI BOARD OF WATER COMMISSIONERS

K 11

K 11

10-23-64

WATER WELL DRILLERS LOG

Date: 10-23, 1964, Driller: Sutter Well Works County Hancock

(Name)

(1) Owner of Land: R. L. Zimmerman

(Name)

Bay St. Louis, Miss.

(Address)

(2) Location: NE 1/4, SW 1/4, Sec. 26 T8SR14W

2 miles NW of Bay St. Louis

(distance)

(direction)

(Nearest Town)

(3) Topography: flat

(Hilly)

(Flat)

(Level)

(4) Purpose of Well: Domestic Home

(Domestic Irrigation Municipal, Industrial, Other)

Description & Color of Materials Sand, Clay, Red Clay, Shell, etc.

Thick-ness Feet

Depth Feet

Clay

65 65

sand-gravel etc.

27 92

Clay

184 276

sand

47 323

Clay

39 362

sand

70 432

Clay

26 458

sand

34 492

Clay

33 525

sand

108 633

Clay-sand streaks

279 912

sand

45 957

Clay

34 991

sand

121 1112

Information upon completion of well:

(1) Diameter 2 inches.

(2) Total Depth 1112 feet.

(3) Water Level 42 feet above Flow below top of ground.

(4) Cased to 1092 alt, Size 2"

(5) Screen: Size 2", Length 20'

(6) Were any formations sealed against pollution?


yes, no.

If YES depth of formation

Why

Drillers Remarks:

USGS Elec log

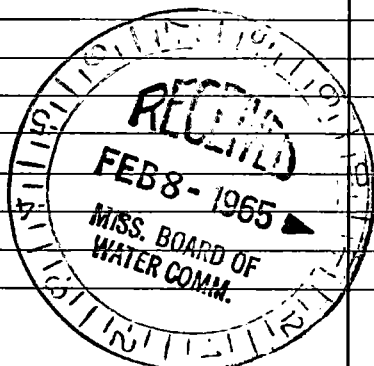

(Use Back Side)

Well No.

