

HANCOCK

MISSISSIPPI BOARD OF WATER COMMISSIONERS

K 22

WATER WELL DRILLERS LOG

CODED

323

8-15-60

Date: 8-15, 1960, Driller: Sutter Well Works County Hancock

(Name)

(1) Owner of Land: H. Marshal

(Name)

Bay St. Louis Miss.

(Address)

42 819

(2) Location: 1/4, 1/4, Sec. T R

10 miles W, of Bay

(distance)

(direction)

(Nearest Town)

(3) Topography: flat

(Hilly)

(Flat)

(Level)

(4) Purpose of Well: domestic

(Domestic Irrigation
Municipal, Industrial, Other)

Description & Color of Materials
Sand, Clay, Red Clay, Shell, etc.

Thick-
ness
Feet

Depth
Feet

Clay

12

12

sand

62

74

Clay

76

150

sand

23

173

Information upon completion of well:

(1) Diameter 2 inches.

(2) Total Depth 173 feet.

(3) Water Level 1 feet above below top of ground.

(4) Cased ~~to~~ all, Size 2"

(5) Screen: Size 2", Length 5'

(6) Were any formations sealed against pollution?


no yes, no.

If YES depth of formation _____

Why _____

Drillers Remarks: _____

CODED

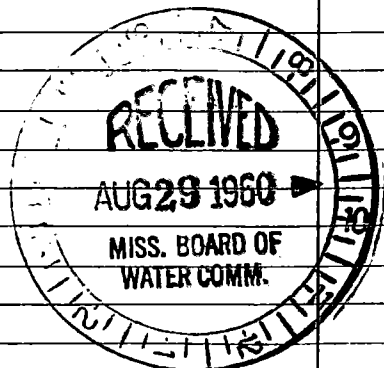

(Use Back Side)

Well No.

