

K23

8-19-60

WATER WELL DRILLERS LOG

CODED 322

Date: 8-19, 1960, Driller: Sutter Well Wks. County Hancock
 (Name)

(1) Owner of Land: PAUL DONZE
 (Name)
BAY ST. LOUIS, MISS.
 (Address)

(2) Location: 1/4, 1/4, Sec. 42 8-14 T R
10 miles NW of BAY
 (distance) (direction) (Nearest Town)

(3) Topography: flat
 (Hilly) (Flat) (Level)

(4) Purpose of Well: domestic
 (Domestic Irrigation
 Municipal, Industrial, Other)

Description & Color of Materials Sand, Clay, Red Clay, Shell, etc.	Thick- ness Feet	Depth Feet
<u>Clay</u>	<u>10</u>	<u>10</u>
<u>sand</u>	<u>28</u>	<u>38</u>
<u>Clay</u>	<u>124</u>	<u>152</u>
<u>sand</u>	<u>42</u>	<u>194</u>

Information upon completion of well:

(1) Diameter 2 inches.

(2) Total Depth 194 feet.

(3) Water Level 1 feet below top of ground.

(4) Cased to all, Size 2"

(5) Screen: Size 2", Length 5'


(6) Were any formations sealed against pollution?
yes, no.

If YES depth of formation _____

Why _____

Drillers Remarks: _____

CODED

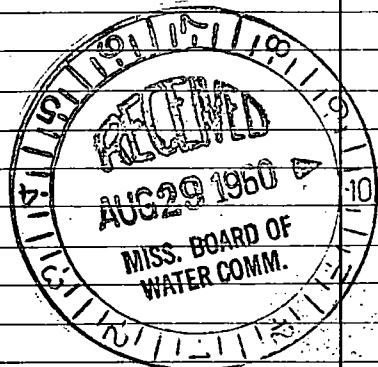

(Use Back Side)

Well No.

