

HANCOCK
K24
8-18-61

MISSISSIPPI BOARD OF WATER COMMISSIONERS

WATER WELL DRILLERS LOG

CODED

301

Date: 8-18, 1961, Driller: Sutter Well Wks. County Hancock

River Gardens (Name)

(1) Owner of Land: Lester Knatt (Name)

Pearlington Miss. (Address)

(2) Location: 10 miles W of Bay St Louis, Sec. 42, T. 8, R. 67

(3) Topography: flat (Hilly) (Flat) (Level)

(4) Purpose of Well: domestic (Domestic Irrigation, Municipal, Industrial, Other)


Description & Color of Materials Sand, Clay, Red Clay, Shell, etc.	Thick- ness Feet	Depth Feet
Sand	35	35
Clay	91	126
Sand	20	146

Information upon completion of well:

- (1) Diameter 2 inches.
- (2) Total Depth 146 feet.
- (3) Water Level 11 feet below top of ground.
- (4) Cased to all, Size 2"
- (5) Screen: Size 2", Length 5'
- (6) Were any formations sealed against pollution?
no.

CODED

If YES depth of formation
Why
Drillers Remarks:

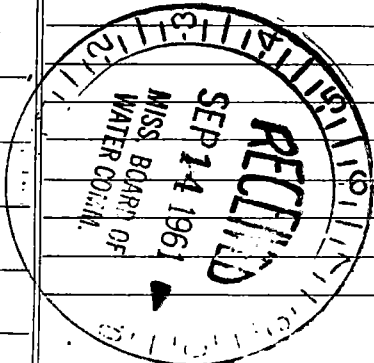

(Use Back Side)

Well No.

