

HANCOCK

MISSISSIPPI BOARD OF WATER COMMISSIONERS

K 25
8-22-61

WATER WELL DRILLERS LOG

CODED

ST 300

Date: 8-22, 1961, Driller: Sutter Well Wks. County Hancock
(Name)

(1) Owner of Land: A.C. Goodwin
(Name)
Rt. 2 Bayst Lewis
(Address)

(2) Location: 32 8 14
10 miles W of Bayst Lewis
(distance) (direction) (Nearest Town)

(3) Topography: flat
(Hilly) (Flat) (Level)

(4) Purpose of Well: domestic
(Domestic Irrigation
Municipal, Industrial, Other)

Description & Color of Materials Sand, Clay, Red Clay, Shell, etc.	Thick- ness Feet	Depth Feet
<u>sand</u>	<u>36</u>	<u>36</u>
<u>clay</u>	<u>98</u>	<u>134</u>
<u>sand</u>	<u>15</u>	<u>149</u>

CODED


Information upon completion of well:

- (1) Diameter 2 inches.
- (2) Total Depth 149 feet.
- (3) Water Level 10 feet below top of ground.
- (4) Cased ~~to~~ all, Size 2"
- (5) Screen: Size 2", Length 5'
- (6) Were any formations sealed against pollution?
yes, no.

If YES depth of formation _____

Why _____

Drillers Remarks: _____

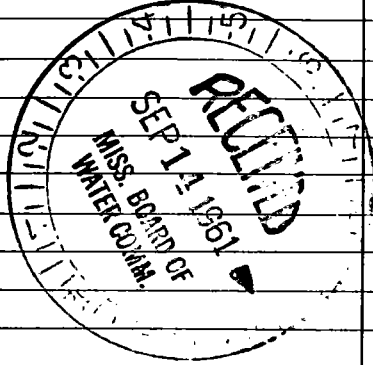

(Use Back Side)

Well No.

Handwritten text at the top of the page, possibly a title or header, which is mostly illegible due to blurriness.

Main body of handwritten text, appearing to be a list or series of entries. The text is very faint and difficult to decipher.

Lower section of handwritten text, continuing the list or entries. Includes some numbers and possibly dates.