

K 26

10-11-61

WATER WELL DRILLERS LOG

CODED B 12

Date: 10-11, 1961, Driller: Sutter Well Wks. County Hancock

(Name)

(1) Owner of Land: Mrs. Nellie Hill
 (Name)
Box 211 - Bay St. Louis, Miss.
 (Address)

(2) Location: SW 1/4, SW 1/4, Sec. 6 T9S R14W
6 miles W of Bay
 (distance) (direction) (Nearst Town)

(3) Topography: level
 (Hilly) (Flat) (Level)

(4) Purpose of Well: domestic
 (Domestic Irrigation
 Municipal, Industrial, Other)

Description & Color of Materials Sand, Clay, Red Clay, Shell, etc.	Thick- ness Feet	Depth Feet
<u>Clay</u>	<u>10</u>	<u>10</u>
<u>sand</u>	<u>35</u>	<u>45</u>
<u>Clay</u>	<u>85</u>	<u>130</u>
<u>sand + gravel</u>	<u>22</u>	<u>152</u>

Information upon completion of well:


- (1) Diameter 1 1/4 inches.
- (2) Total Depth 152 feet.
- (3) Water Level 9 feet below top of ground.
- (4) Cased to all, Size 1 1/4".
- (5) Screen: Size 1 1/4, Length 5'.
- (6) Were any formations sealed against pollution?
 _____ yes, no.

If YES depth of formation _____

Why _____

Drillers Remarks: _____

CODED

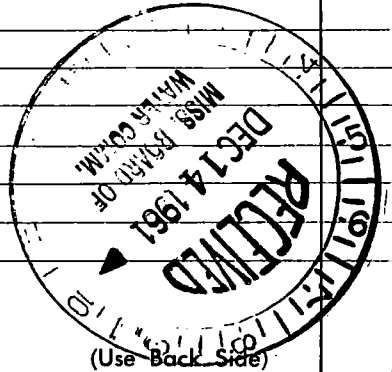

Well No.

1000

Handwritten notes and scribbles at the top of the page, including some illegible characters and lines.

Large area of handwritten scribbles and faint markings in the middle section of the page.

Bottom section of the page containing more handwritten scribbles and faint traces of text.