

**K29**  
6-11-62

WATER WELL DRILLERS

**CODED**

OK PM  
337

Date: 6-11, 1962, Driller: Sutton Well Works County Hancock  
(Name)

(1) Owner of Land: N. Lapara  
(Name)  
New Orleans La.  
(Address)

(2) Location: NE 1/4, NE 1/4, Sec. 30 T8S R14W  
14 miles W of Bay St Louis  
(distance) (direction) (Nearest Town)

(3) Topography: flat  
(Hilly) (Flat) (Level)

(4) Purpose of Well: domestic  
(Domestic Irrigation  
Municipal, Industrial, Other)

Description & Color of Materials Sand, Clay, Red Clay, Shell, etc.	Thick- ness Feet	Depth Feet
Clay	10	10
sand	25	35
Clay	10	45
sand	10	55
Clay	35	90
sand	20	110

Information upon completion of well:

(1) Diameter 2 inches.

(2) Total Depth 110 feet.

(3) Water Level surface feet below top of ground.

(4) Cased to all, Size 2"

(5) Screen: Size 2", Length 5'


(6) Were any formations sealed against pollution?  
no

**CODED**

If YES depth of formation \_\_\_\_\_

Why \_\_\_\_\_

Drillers Remarks: \_\_\_\_\_

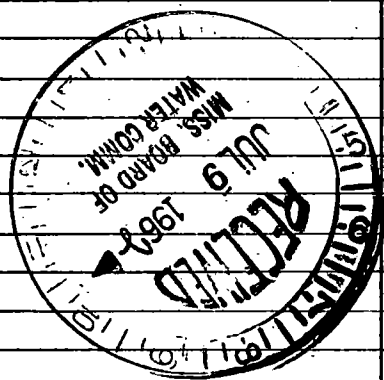

(Use Back Side)

Well No.

Handwritten notes at the top of the page, including a circled '1' and some illegible text.

Vertical handwritten notes on the left side of the page, possibly a list or index.

Main body of handwritten notes on the right side, including a large heading that appears to be 'Bibliography'.

Extensive vertical handwritten notes on the left side, continuing down the page.

Continuation of handwritten notes on the right side, including a section with a checkmark and a downward-pointing arrow.