

K33

5-24-63

WATER WELL DRILLERS LOG

CODED

K

Date: 5-24, 1963, Driller: Sutton Well Works County Hancock

(Name)

(1) Owner of Land: F.E. Lassche (Name) Pass Christian, Miss. (Address)

(2) Location: NE 1/4, NE 1/4, Sec. 5 T9S R14W 6 miles W of Bay St Louis (distance) (direction) (Nearest Town)

(3) Topography: flat (Hilly) (Flat) (Level)

(4) Purpose of Well: domestic (Domestic Irrigation Municipal, Industrial, Other)

Description & Color of Materials Sand, Clay, Red Clay, Shell, etc.

Thickness Feet

Depth Feet

sand

30

30

clay

61

91

sand

19

110

CODED

Information upon completion of well:


- (1) Diameter 2 inches. (2) Total Depth 110 feet. (3) Water Level 8 feet below top of ground. (4) Cased to all, Size 2". (5) Screen: Size 2", Length 5'. (6) Were any formations sealed against pollution?

yes, no.

If YES depth of formation


Why

Drillers Remarks:

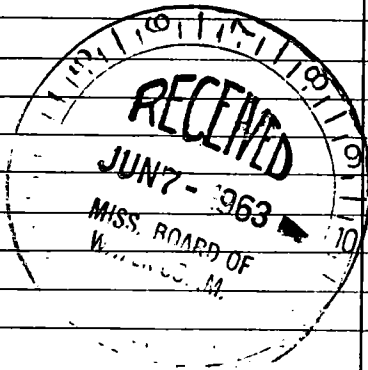

(Use Back Side)

Well No.

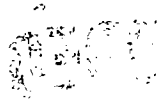

MEMORANDUM FOR THE RECORD

On 10/10/44, the following information was received from the [redacted] office:

[The remainder of the page contains extremely faint and illegible text, likely a memorandum or report. The text is mostly obscured by noise and low contrast in the scan.]