

HANCOCK  
K45  
8-12-63

WATER WELL DRILLERS LOG **CODED** <sup>24</sup>

Date: 8-12, 1963, Driller: Sutter Well Works County Hancock  
(Name)

(1) Owner of Land: Redi-Bilt Homes  
(Name)  
Bay St. Louis, Miss.  
(Address)

(2) Location: NE 1/4, SW 1/4, Sec. 48 T25R14W  
5 miles W, of Bay  
(distance) (direction) (Nearest Town)

(3) Topography: flat  
(Hilly) (Flat) (Level)

(4) Purpose of Well: domestic  
(Domestic Irrigation  
Municipal, Industrial, Other)

Description & Color of Materials Sand, Clay, Red Clay, Shell, etc.	Thick- ness Feet	Depth Feet
Clay	16	16
sand	22	38
clay	12	50
sand	24	74
clay	52	126
sand	48	174

Information upon completion of well:

(1) Diameter 1 1/4 inches.

(2) Total Depth 174 feet.

(3) Water Level 1 feet below top of ground.

(4) Cased to all, Size 1 1/4"

(5) Screen: Size 1 1/4", Length 5'


(6) Were any formations sealed against pollution?  
yes,  no.

If YES depth of formation \_\_\_\_\_

Why \_\_\_\_\_

Drillers Remarks: \_\_\_\_\_

**CODED**

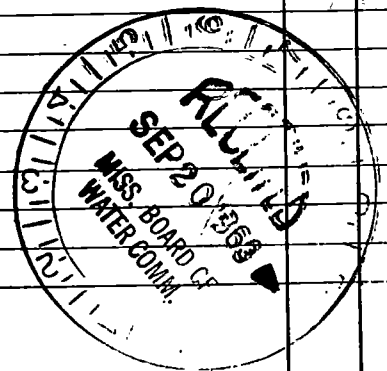

(Use Back Side)

Well No.

012345

1 2 3 4 5 6 7 8 9 10 11 12

13 14 15 16 17 18 19 20 21 22 23 24 25

26 27 28 29 30 31 32 33 34 35 36 37 38 39 40

---

41 42 43 44 45 46 47 48 49 50 51 52 53 54 55

56 57 58 59 60 61 62 63 64 65 66 67 68 69 70

71 72 73 74 75 76 77 78 79 80 81 82 83 84 85

86 87 88 89 90 91 92 93 94 95 96 97 98 99 100

---

101 102 103 104 105 106 107 108 109 110 111 112 113 114 115

116 117 118 119 120 121 122 123 124 125 126 127 128 129 130