

K49
7-15-65

WATER WELL DRILLERS LOG

^{K49}
CODED

Date: 7-15, 1965, Driller: Sutter Well Works County Hancock
(Name)

(1) Owner of Land: Chester H. Slawson
(Name)
Rt 4 Box 460 B Picayune, Miss
(Address)

(2) Location: NW 1/4, SE 1/4, Sec. 17 T8SR 14W
6 miles W of Baptown
(distance) (direction) (Nearest Town)

(3) Topography: flat
(Hilly) (Flat) (Level)

(4) Purpose of Well: domestic
(Domestic Irrigation
Municipal, Industrial, Other)

Description & Color of Materials Sand, Clay, Red Clay, Shell, etc.	Thick- ness Feet	Depth Feet
<u>Clay</u>	<u>20</u>	<u>20</u>
<u>Sand</u>	<u>15</u>	<u>35</u>
<u>Clay</u>	<u>54</u>	<u>89</u>
<u>sand</u>	<u>19</u>	<u>108</u>
<u>Clay</u>	<u>22</u>	<u>130</u>
<u>sand</u>	13	143
	<u>13</u>	<u>143</u>

Information upon completion of well:

(1) Diameter 2 inches.

(2) Total Depth 143 feet.

(3) Water Level 1 feet below top of ground.


(4) Cased to all, Size 2"

(5) Screen: Size 2", Length 5'

(6) Were any formations sealed against pollution?
no


CODED

If YES depth of formation _____
Why _____
Drillers Remarks: _____

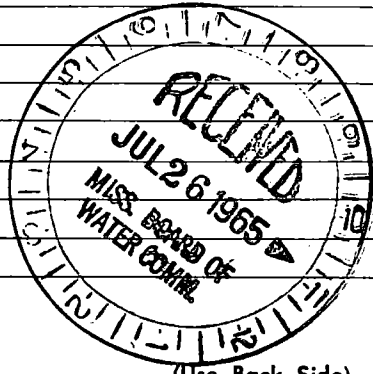

(Use Back Side)

Well No. _____

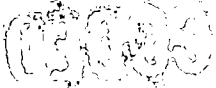

Handwritten text at the top, possibly a title or header, including the word "Lecture".

Vertical handwritten notes on the left side of the page.

Handwritten notes in the middle-left section of the page.

Main body of handwritten notes on the right side of the page, including a diagram of a structure.

Vertical handwritten notes on the right side, lower down.

193

1

193

1