

MISSISSIPPI
BOARD OF WATER COMMISSIONERS
416 North State Street
Jackson, Mississippi 39201

CODED

WATER WELL DRILLERS LOG

9-26

1967 Powell Water Well

Hancock

date well completed

firm name

county well located

LANDOWNER: Unknown

Otto Baugien

Bay St. Louis, Miss.
(mailing address)

description of formations encountered

from to

Sand & Black Soil 0 20
Top
Med. soft mud on clay 20 150

WELL LOCATION:

sec. 26 T. 2 N. R. 14 E.
1/2 miles out of city of Bay St. Louis
(distance) (direction) (nearest town)

Coarse sand & 157 226
Plenty of water

WELL PURPOSE:

(home, irrigation, municipal, industrial)

app 75ft

of sand to produce water

WELL COMPLETION DATA:

- (1) diameter (inches) 2"
- (2) total depth (feet) 226'
- (3) static water level (feet) 15' below/above top of ground.
- (4) casing 2" gal, 201'
(material) (depth)


This well is for a car wash only

- (5) screen 15', 211'
(length) (depth to top)
- 2', sid on gal
(size) (material)
- (6) pump 1/2, 1028 gph
(HP) (yield gph)
- Etc
(type power)

- (7) electric log None
(yes or no)
- None
(organization running log)

- (8) how well bottom plugged 2" B.W.
value


DRILLERS REMARKS:

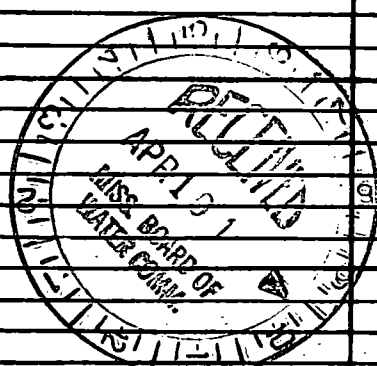

CODED

If well telescopes please sketch and show depths.

GROUND LEVEL

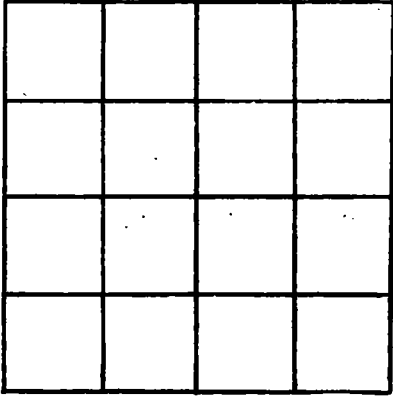

SECTION _____

Please indicate well location X.

ADDITIONAL INFORMATION

A series of horizontal lines for recording additional information, starting below the 'ADDITIONAL INFORMATION' header and extending to the bottom of the page.

If more than one screen, show locations of each on sketch.