

CODED

MISSISSIPPI  
BOARD OF WATER COMMISSIONERS  
416 North State Street  
Jackson, Mississippi 39201

WATER WELL DRILLERS LOG

Hancock  
K 82  
11-13-68

11-13 1968 Penion Well Serv Hancock  
date well completed firm name county well located

LANDOWNER: A. J. Richards  
405 100th Ave.  
Clearmont Harbor, Miss  
(mailing address)

WELL LOCATION:  
sec. 17 T-9 S R-14 W  
miles \_\_\_\_\_ of \_\_\_\_\_  
(distance) (direction) (nearest town)


WELL PURPOSE: Home  
(home, irrigation, municipal, industrial)

WELL COMPLETION DATA: 4 1/2 Drilled

- (1) diameter (inches) 2"
- (2) total depth (feet) 110
- (3) static water level (feet) 7' below top of ground.
- (4) casing Galv, 105'  
(material) (depth)  
2" If telescope see back.  
(size)
- (5) screen 5', 105'  
(length) (depth to top)
- 012 2", S. Steel  
(size) (material)
- (6) pump  (HP)  (yield gpm)  
(type power)
- (7) electric log NO  
(yes or no)  
(organization running log)
- (8) how well bottom plugged BUV Valve

description of formations encountered	from	to
Surface Clay	0	22
Sand	22	38
Grey Clay	28	42
Brown Sand	42	65
Blue Clay	65	93
Sand	93	110

CODED

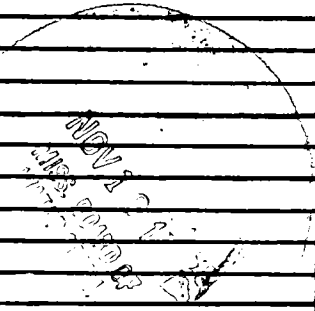

DRILLERS REMARKS:  
15 GPM. Pumped with Air-

If well telescopes please sketch and show depths.

405 100r Ave

GROUND LEVEL


SECTION 17

Please indicate well location X.

ADDITIONAL INFORMATION

If more than one screen, show locations of each on sketch.