

Hancock
K 84
8-67

MISSISSIPPI
BOARD OF WATER COMMISSIONERS
416 North State Street
Jackson, Mississippi 39201

BODED

WATER WELL DRILLERS LOG

8-26 1967 firm name pinwill water wks Hancock county well located

LANDOWNER: W. Rooney
2 Shore Line Prop
Bay St. Louis, Miss
(mailing address)

description of formations encountered	from	to
<u>Sandy soil top</u>	<u>0</u>	<u>20'</u>
<u>Mixed sand & silt</u>	<u>20</u>	<u>90</u>
<u>Dist</u>		
<u>white sand & gravel</u>	<u>90</u>	<u>115</u>
<u>sea</u>		
<u>hard Blue mud</u>	<u>100</u>	<u>155</u>
<u>or clay</u>		
<u>good water sand</u>	<u>155</u>	<u>178</u>
<u>& clam shell</u>		


WELL LOCATION:
sec. 39 T 8 N R. 1 E
5 miles WSW of Bay St
(distance) (direction) (nearest town)

WELL PURPOSE:
(home, irrigation, municipal, industrial)

WELL COMPLETION DATA:

- (1) diameter (inches) 2"
- (2) total depth (feet) 178'
- (3) static water level (feet) 2 ~~below~~ ^{above} top of ground.
- (4) casing 2" gal, 168'
(material) (depth)
- None if telescope see back.
(size)
- (5) screen 10', 168"
(length) (depth to top)
- 2", S.S. on gal.
(size) (material)
- (6) pump 1/2
(HP) (yield gpm)
- elec
(type power)
- (7) electric log None
(yes or no)
- none
(organization running log)
- (8) how well bottom plugged 2" BW
valve


BODED

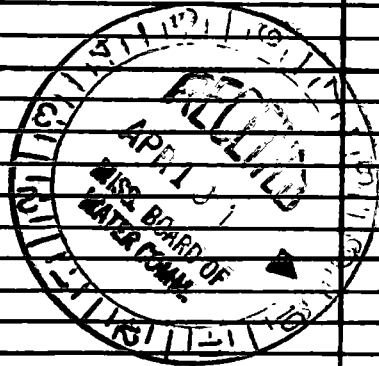

DRILLERS REMARKS:

If well telescopes please sketch and show depths.

GROUND LEVEL

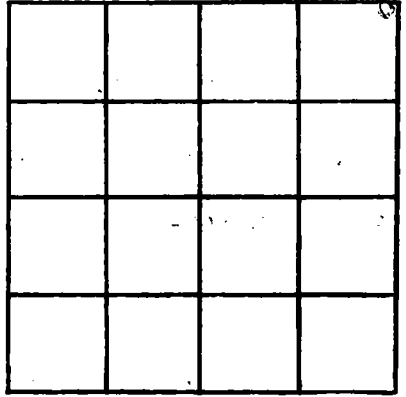

SECTION _____

Please indicate well location X.

ADDITIONAL INFORMATION

If more than one screen, show locations of each on sketch.