

Hancock  
K 85  
1-67

MISSISSIPPI  
BOARD OF WATER COMMISSIONERS  
416 North State Street  
Jackson, Mississippi 39201

BODED

WATER WELL DRILLERS LOG

1-13-67 date well completed      1967 Pinnacle Well Works firm name      Hancock county well located

LANDOWNER: C.A. Roover  
#1 Jay place  
Wegman La  
(mailing address)

WELL LOCATION:  
sec. 39 4 N R. 14 E  
5 miles west of Big Horn  
(distance) (direction) (nearest town)

WELL PURPOSE: Home  
(home, irrigation, municipal, industrial)


WELL COMPLETION DATA:

- (1) diameter (inches) 1 1/4 inch
- (2) total depth (feet) 134
- (3) static water level (feet) 8' below above top of ground.
- (4) casing gal pipe 134  
(material) (depth)  
(size) if telescope see back.
- (5) screen 10' 124'  
(length) (depth to top)  
1/4 gal screen  
(size) (material)
- (6) pump 1/8 Chc.  
(HP) (yield gpm)  
(type power)
- (7) electric log no  
(yes or no)  
none  
(organization running log)
- (8) how well bottom plugged 1/4" clay  
mark check valve

description of formations encountered	from	to
Sand p	0'	28'
from Reg old Blue Clays	28'	104'
Sand & clam shell	104'	134'


Sir  
if this report  
is not filled out  
properly please  
advise so.  
Thank  
Melford  
I am sending all  
of this log  
into the  
MISSISSIPPI BOARD OF WATER COMMISSIONERS

DRILLERS REMARKS:

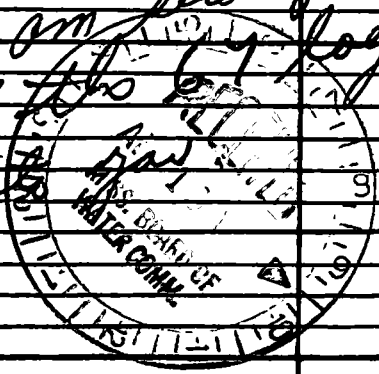

If well telescopes please sketch and show depths.

GROUND LEVEL

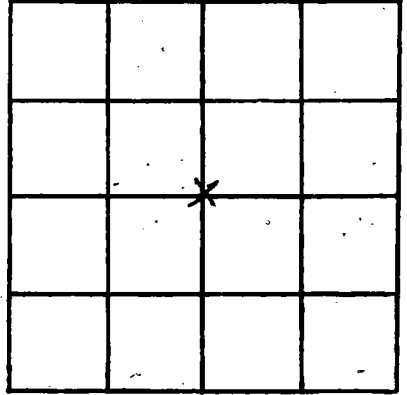

SECTION 39

Please indicate well location X.

ADDITIONAL INFORMATION

If more than one screen, show locations of each on sketch.