

CODED

MISSISSIPPI
BOARD OF WATER COMMISSIONERS
416 North State Street
Jackson, Mississippi 39201

CODED

WATER WELL DRILLERS LOG

Hancock
K 86
5-23-68

5-23 1968 Pinville Water Well Hancock
date well completed firm name county well located

LANDOWNER: Edward Meyer

description of formations encountered

from to

Shore line Park
Bay St. Louis, Miss
(mailing address)

<u>Blue marl Mud</u>	<u>0</u>	<u>20</u>
<u>Light fine sand</u>	<u>20</u>	<u>30</u>
<u>Blue clay</u>	<u>30</u>	<u>100</u>
<u>fine water sand</u>	<u>100</u>	<u>118</u>
<u>hard Blue clay</u>	<u>118</u>	<u>160</u>
<u>Mud</u>	<u>160</u>	<u>184</u>
<u>Coar water sand</u>	<u>160</u>	<u>184</u>
<u>app. 24 ft of sand.</u>		

WELL LOCATION:

sec 28 T 8 N R 14 E
6 miles West of Bay St Louis
(distance) (direction) (nearest town)

WELL PURPOSE: home
(home, irrigation, municipal, industrial)

WELL COMPLETION DATA:

- (1) diameter (inches) 2"
- (2) total depth (feet) 184'
- (3) static water level (feet) 0 below above top of ground.

(4) casing galvne, 184
(material) (depth)

_____ If telescope see back.
(size)

(5) screen 10', 174
(length) (depth to top)

2", S. S. screen
(size) (material)

(6) pump 0 0
(HP) (yield gpm)

0
(type power)

(7) electric log no
(yes or no)

None
(organization running log)

(8) how well bottom plugged 2" Spring
Back wash valve

DRILLERS REMARKS:


CODED

DEC 10 1968

MISS. BD. OF
WATER COMM.

If well telescopes please sketch and show depths.

GROUND LEVEL

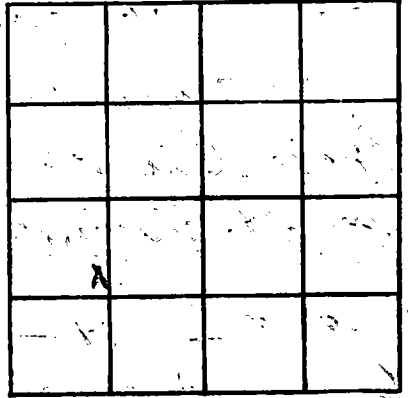

SECTION 28

Please indicate well location X.

ADDITIONAL INFORMATION

If more than one screen, show locations of each on sketch.