

Hancock Co  
K 91  
5-67

MISSISSIPPI BOARD OF WATER COMMISSIONERS  
416 North State Street  
Jackson, Mississippi 39201

CODED  
CODED

WATER WELL DRILLERS LOG

April 24 1967 FAURE WELL WORKS Hancock  
date well completed firm name county well located

LANDOWNER: Harold Johnson  
St. Charles St.  
Box St. Louis Miss  
(mailing address)

WELL LOCATION:  
sec. 39 T. 85 N. R. 14 W. E  
5 miles N.W. of Bryant, La.  
(distance) (direction) (nearest town)

WELL PURPOSE: HOME  
(home, irrigation, municipal, industrial)

WELL COMPLETION DATA:

- (1) diameter (inches) 2"
- (2) total depth (feet) 131
- (3) static water level (feet) ground level below top of group.
- (4) casing Plastic, 127  
(material) (depth)
- (size) if telescope see back.
- (5) screen 5", 127  
(length) (depth to top)
- 2, Plastic  
(size) (material)
- (6) pump \_\_\_\_\_  
(HP) (yield gpm)
- (type power)
- (7) electric log \_\_\_\_\_  
(yes or no)
- (organization running log)
- (8) how well bottom plugged Back  
wash valve

description of formations encountered	from to	
RED CLAY	0	21
MARSH MUD		
SAND & GRAVEL	21	42
BLUE CLAY & SHELLS	42	63
" " "	63	84
" " "	84	105
BLUE SAND	105	127
WASH DOWN IN SAND	127	

MODEL


05/14 11-26-68

MAR 4 1969


MISS. BD. OF WATER COMMISSIONERS

DRILLERS REMARKS:

If well telescopes please sketch and show depths.

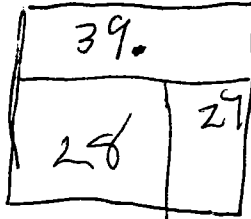

GROUND LEVEL

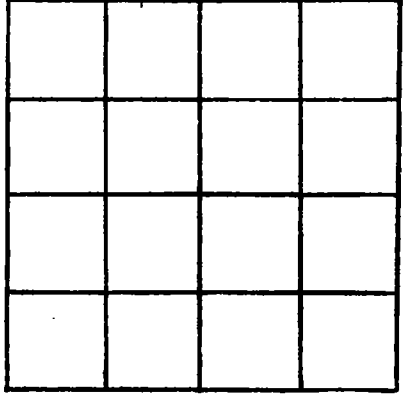

SECTION \_\_\_\_\_

Please indicate well location X.

ADDITIONAL INFORMATION

If more than one screen, show locations of each on sketch.