

Hancock
K94
10-24-68

MISSISSIPPI
BOARD OF WATER COMMISSIONERS
416 North State Street
Jackson, Mississippi 39201

CODED
CODED

WATER WELL DRILLERS LOG

10-24 1968 date well completed
Lutter Well Works firm name
Hancock county well located

FOR LANDOWNER: LEW MONTI

Bay St. Louis,
Miss.
(mailing address)

description of formations encountered	depth	
	from	to
Clay	0	40
sand	40	78
clay	78	106
sand	106	128
clay	128	155
sand	155	173

WELL LOCATION:


sec. 40 T. 8 N. R. 14 E.
Shoreline Park W.
miles Bay St. Louis (distance) (direction) (nearest town)

WELL PURPOSE: home
(home, irrigation, municipal, industrial)

WELL COMPLETION DATA:

- (1) diameter (inches) 2
- (2) total depth (feet) 173
- (3) static water level (feet) 1 below top of ground.
- (4) casing galv. 168' (material) (depth)
2" (size) if telescope see back.
- (5) screen 5' 168' (length) (depth to top)
2" (size) Stainless Steel (material)
- (6) pump unknown (HP) (yield gpm)
(type power)
- (7) electric log no (yes or no)
(organization running log)
- (8) how well bottom plugged B.P. value

DRILLERS REMARKS:

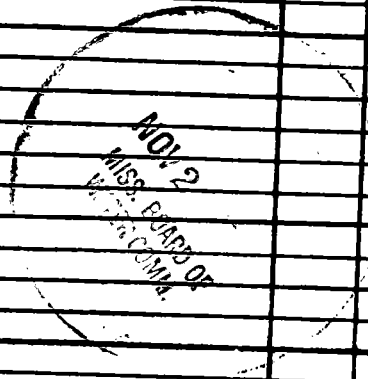

If well telescopes please sketch and show depths.

GROUND LEVEL

SECTION _____

Please indicate well location X.

ADDITIONAL INFORMATION

If more than one screen, show locations of each on sketch.