

Hancock
K 95
10-25-68

MISSISSIPPI
 BOARD OF WATER COMMISSIONERS
 416 North State Street
 Jackson, Mississippi 39201

CODED
 CODED

WATER WELL DRILLERS LOG

10-25 1968 Sutter Well Works Hancock
 date well completed firm name county well located

LANDOWNER: J B Biquin
Bay St. Louis
Miss
 (mailing address)

WELL LOCATION:
 sec. 35 T. 8 N. R. 14 E.
S W
E Bay St. Louis
 (distance) miles (direction) (nearest town)

WELL PURPOSE: home
 (home, irrigation, municipal, industrial)

- WELL COMPLETION DATA:
- (1) diameter (inches) 2
 - (2) total depth (feet) 436
 - (3) static water level (feet) 7 1/2 below above top of ground.
 - (4) casing galv. 421'
 (material) (depth)
2"
 (size) if telescope see back.
 - (5) screen 15' 421
 (length) (depth to top)
2" Stainless Steel
 (size) (material)
 - (6) pump 1 15
 (HP) (yield gpm)
elec
 (type power)
 - (7) electric log no
 (yes or no)
 - (organization running log)
 - (8) how well bottom plugged BP Valve

description of formations encountered	from	to
<u>sand</u>	<u>0</u>	<u>58</u>
<u>clay</u>	<u>58</u>	<u>96</u>
<u>sand</u>	<u>96</u>	<u>145</u>
<u>clay</u>	<u>145</u>	<u>298</u>
<u>sand</u>	<u>298</u>	<u>320</u>
<u>clay</u>	<u>320</u>	<u>381</u>
<u>sand</u>	<u>381</u>	<u>436</u>


LOG # 11



DRILLERS REMARKS:

If well telescopes please
sketch and show depths.

GROUND LEVEL

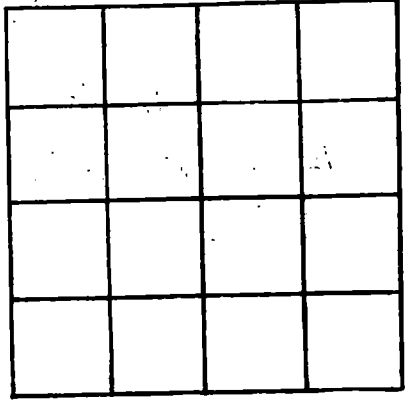

SECTION _____

Please indicate well location X.

ADDITIONAL INFORMATION

If more than one screen,
show locations of each on sketch.