

Hancock
K97
11-15-68

MISSISSIPPI
BOARD OF WATER COMMISSIONERS
416 North State Street
Jackson, Mississippi 39201

CODED
CODED

WATER WELL DRILLERS LOG

11-15 1968 date well completed
Futter Well Works firm name
Hancock county well located

LANDOWNER: P H Patterson
2674 Acacia St
New Orleans La.
(mailing address)

description of formations encountered	from	to
Clay	0	18
sand	18	38
Clay	38	72
sand	72	90
Clay	90	121
sand	121	152

WELL LOCATION:
sec. 40 T. 8 N. R. 14 E. S. 5 W.
Shoreline Park
miles (distance) of (nearest town)

WELL PURPOSE: home
(home, irrigation, municipal, industrial)

- WELL COMPLETION DATA:
- (1) diameter (inches) 2
 - (2) total depth (feet) 152
 - (3) static water level (feet) — below top of ground.
 - (4) casing galv. 147' (material) (depth)
2" (size) if telescope see back.
 - (5) screen 5' 147' (length) (depth to top)
2" (size) stainless steel (material)
 - (6) pump 1/3 (HP) 10 (yield gpm)
elec (type power)
 - (7) electric log no (yes or no)

(organization running log)

(8) how well bottom plugged B.P. Valve


DRILLERS REMARKS:

FEB 13 1969

MISS. BD. OF WATER COMM.

If well telescopes please sketch and show depths.

GROUND LEVEL

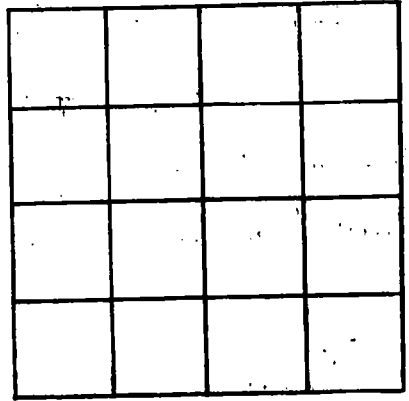

SECTION _____

Please indicate well location X.

ADDITIONAL INFORMATION

Lined area for additional information.

If more than one screen, show locations of each on sketch.