

Hancock
 K19
 2-3-69

MISSISSIPPI
 BOARD OF WATER COMMISSIONERS
 416 North State Street
 Jackson, Mississippi 39201

CODED
 CODED

WATER WELL DRILLERS LOG

2-3 1969 Sutter Well Works Hancock
 date well completed firm name county well located

LANDOWNER: Harold Kumpa
10910 Chef Menteur Highway
New Orleans La.
 (mailing address)

description of formations encountered	from to	
<u>sand</u>	<u>10</u>	<u>25</u>
<u>clay</u>	<u>25</u>	<u>130</u>
<u>sand</u>	<u>130</u>	<u>152</u>

WELL LOCATION: Shoreline Park
 sec. 40 T. 8 N. R. 14 E. S. 1
 miles _____ of _____
 (distance) (direction) (nearest town)

WELL PURPOSE: home home
 (home, irrigation, municipal, industrial)

WELL COMPLETION DATA:

- (1) diameter (inches) 2
- (2) total depth (feet) 152
- (3) static water level (feet) 1 ^{below} above top of ground.
- (4) casing Galv. 147'
 (material) (depth)
2"
 (size) if telescope see back.
- (5) screen 5 147'
 (length) (depth to top)
2" stainless steel
 (size) (material)
- (6) pump 1/3 10
 (HP) (yield gpm)
elec
 (type power)
- (7) electric log no
 (yes or no)

(organization running log)

(8) how well bottom plugged BP Valve

DRILLERS REMARKS:


CODED

FEB 13 1969

MISS. RD. OF WATER COM. CONTROL

If well telescopes please sketch and show depths.

GROUND LEVEL

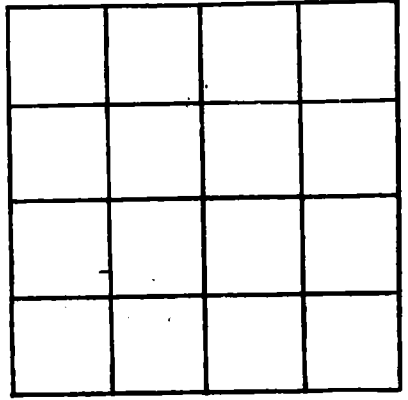

SECTION _____

Please indicate well location X.

ADDITIONAL INFORMATION

If more than one screen,
show locations of each on sketch.