

MISSISSIPPI  
BOARD OF WATER COMMISSIONERS  
416 North State Street  
Jackson, Mississippi 39201

WATER WELL DRILLERS LOG

9-30 1968 Sutter Well Works Hancock  
date well completed firm name county well located

LANDOWNER: Lambert Berdege  
Pleasure St  
Lakeshore Miss.  
(mailing address)

WELL LOCATION:  
sec. 18 T. 9 N. R. 14 E.  
1 miles S of Lakeshore (nearest town)  
(distance) (direction)

WELL PURPOSE: Out-division  
(home, irrigation, municipal, industrial)


WELL COMPLETION DATA:

- (1) diameter (inches) 2
- (2) total depth (feet) 807'
- (3) static water level (feet) ? below top of ground.
- (4) casing Galv. 787'  
(material) (depth)  
2"  
(size) If telescope see back.
- (5) screen 20' 787'  
(length) (depth to top)  
2" Stainless Steel  
(size) (material)
- (6) pump none  
(HP) (yield gpm)  
(type power)
- (7) electric log no  
(yes or no)  
(organization running log)
- (8) how well bottom plugged BPU

Description of formations encountered	from to	
Clay	0	25
Sand	25	50
Clay	50	180
Sand	180	230
Clay	230	300
Sand & gravel	300	386
Clay	386	588
Sand	588	598
Clay	598	651
Sand	651	807

CODED

CODED

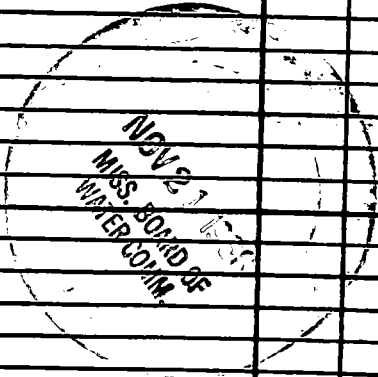

DRILLERS REMARKS:

If well telescopes please sketch and show depths.

GROUND LEVEL


SECTION \_\_\_\_\_

Please indicate well location X.

ADDITIONAL INFORMATION

If more than one screen, show locations of each on sketch.