

Hancock
11-1-68

MISSISSIPPI
 BOARD OF WATER COMMISSIONERS CODED
 416 North State Street
 Jackson, Mississippi 39201

WATER WELL DRILLERS LOG CODED

date well completed 11-1 1968 firm name Sutter Well Works county well located Hancock

LANDOWNER: Rent Sellier
Clermont Harbor

description of formations encountered	from	to
<u>Clay</u>	<u>0</u>	<u>10</u>
<u>Sand</u>	<u>10</u>	<u>20</u>
<u>Clay</u>	<u>20</u>	<u>35</u>
<u>Sand</u>	<u>35</u>	<u>65</u>
<u>Clay</u>	<u>65</u>	<u>170</u>
<u>Sand</u>	<u>170</u>	<u>201</u>
<u>Clay</u>	<u>201</u>	<u>278</u>
<u>Sand</u>	<u>278</u>	<u>304</u>

Miss -
 (mailing address)

WELL LOCATION:
 sec M-T-9 N R-14 E
S W
 (distance) in Clermont Harbor (direction) (nearest town)

WELL PURPOSE: home
 (home, irrigation, municipal, industrial)


WELL COMPLETION DATA:

- (1) diameter (inches) 2"
- (2) total depth (feet) 304
- (3) static water level (feet) 8 below above top of ground.
- (4) casing Galv. 294'
 (material) (depth)
2"
 (size) If telescope see back.
- (5) screen 10 294'
 (length) (depth to top)
2" stainless steel
 (size) (material)
- (6) pump 1 15
 (HP) (yield gpm)
elec
 (type power)
- (7) electric log no
 (yes or no)

(organization running log)


(8) how well bottom plugged B.P. Value

DRILLERS REMARKS:

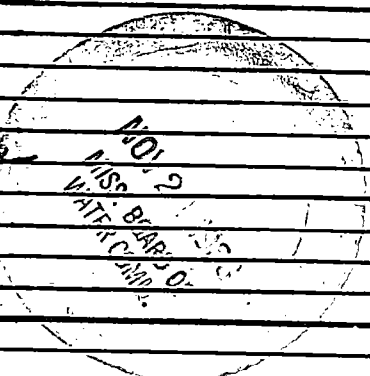

If well telescopes please sketch and show depths.

GROUND LEVEL

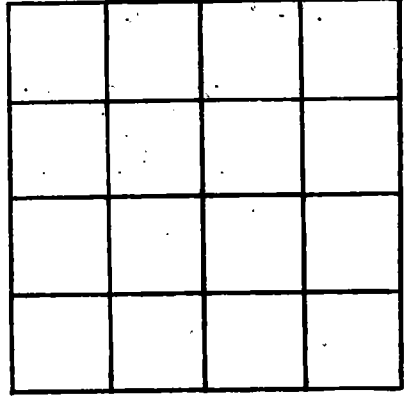

SECTION _____

Please indicate well location X.

ADDITIONAL INFORMATION

If more than one screen, show locations of each on sketch.