

Hancock
K102
11-13-68

MISSISSIPPI
 BOARD OF WATER COMMISSIONERS
 416 North State Street
 Jackson, Mississippi 39201

CODED

CODED

WATER WELL DRILLERS LOG

11-13 19*68*
 date well completed

Intex Well Works
 firm name

Hancock
 county well located

LANDOWNER: *John Klein*
Clermont Harbor

description of formations encountered

from to

Triss
 (mailing address)

<i>Clay</i>	<i>0</i>	<i>10</i>
<i>Sand</i>	<i>10</i>	<i>68</i>
<i>Clay</i>	<i>68</i>	<i>178</i>
<i>Sand</i>	<i>178</i>	<i>210</i>
<i>Clay</i>	<i>210</i>	<i>274</i>
<i>Sand</i>	<i>274</i>	<i>304</i>

WELL LOCATION:

sec *7* T *9* N R *14* E
 S W
 miles *11* of *Clermont Harbor*
 (distance) (direction) (nearest town)


WELL PURPOSE: *home*
 (home, irrigation, municipal, industrial)

WELL COMPLETION DATA:

- (1) diameter (inches) *2*
- (2) total depth (feet) *304*
- (3) static water level (feet) *9* below top of ground.
- (4) casing *Galv.* *294'*
 (material) (depth)
3" if telescope see back.
 (size)
- (5) screen *10'* *294'*
 (length) (depth to top)
2" *stainless steel*
 (size) (material)
- (6) pump *unknown*
 (HP) (yield gpm)
 (type power)
- (7) electric log *no*
 (yes or no)
 (organization running log)
- (8) how well bottom plugged *B.P. Valve*


CODED

DRILLERS REMARKS:

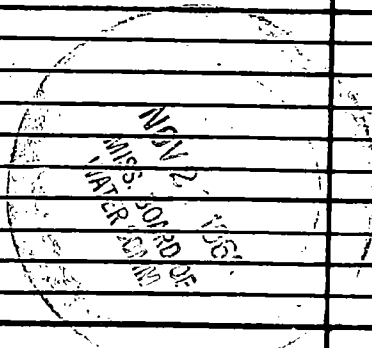

If well telescopes please sketch and show depths.

GROUND LEVEL

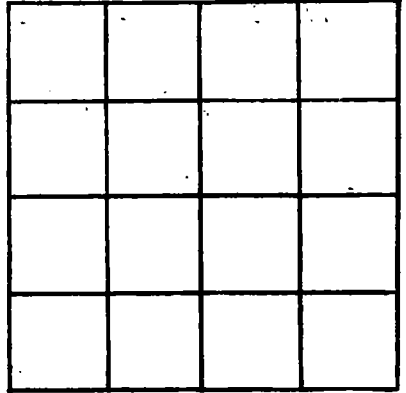

SECTION _____

Please indicate well location X.

ADDITIONAL INFORMATION

If more than one screen, show locations of each on sketch.