

**MISSISSIPPI  
BOARD OF WATER COMMISSIONERS  
416 North State Street  
Jackson, Mississippi 39201**

**INDEXED**

**WATER WELL DRILLERS LOG**

**INDEXED**

Hancock  
K103  
1-29-69

date well completed 1-29 1969 firm name Sutter Well Works county well located Hancock

LANDOWNER: H F Pastagne  
10514 Chadwick St  
New Orleans 23, La.  
(mailing address)

description of formations encountered	from to	
	ft	ft
<u>Sand</u>	<u>0</u>	<u>30</u>
<u>Clay</u>	<u>30</u>	<u>120</u>
<u>Sand</u>	<u>120</u>	<u>131</u>
<u>Clay</u>	<u>131</u>	<u>162</u>
<u>Sand</u>	<u>162</u>	<u>173</u>

WELL LOCATION: Bay Side Park  
sec. 5 T 9 N R 14 E S  
Bay St Louis  
(distance) (direction) (nearest town)

WELL PURPOSE: Home  
(home, irrigation, municipal, industrial)

**WELL COMPLETION DATA:**

- (1) diameter (inches) 2
- (2) total depth (feet) 173
- (3) static water level (feet) 14  below  above top of ground.
- (4) casing Galv 168'  
(material) (depth)  
2"  
(size) if telescope see back.
- (5) screen 5' 168'  
(length) (depth to top)  
2" Stainless Steel  
(size) (material)
- (6) pump 1/2 10  
(HP) (yield gpm)  
elec  
(type power)
- (7) electric log no  
(yes or no)  
  
(organization running log)
- (8) how well bottom plugged BPI/...

**INDEXED**


**FEB 13 1969**

**MISS. BD. OF WATER COMMISSIONERS**

DRILLERS REMARKS: \_\_\_\_\_

If well telescopes please sketch and show depths.

GROUND LEVEL

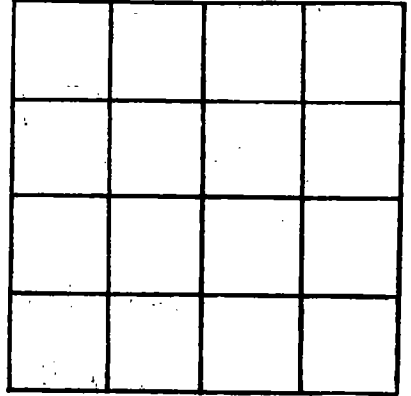

SECTION \_\_\_\_\_

Please indicate well location X.

ADDITIONAL INFORMATION

If more than one screen,  
show locations of each on sketch.