

Hancock
K 106
6-69

MISSISSIPPI
BOARD OF WATER COMMISSIONERS
416 North State Street
Jackson, Mississippi 39201

CODED

WATER WELL DRILLERS LOG

WELL LUMPKIN WELL DRILLING SERVICE
P. O. BOX 117

Hancock

6-18 1969
date well completed

JACKSON, MISS.

county well located

LANDOWNER: Jordan Kiver
Estate
904 Hwy 11 South
Picayune, Miss.
(mailing address)

description of formations encountered	from	to
Surface clay	0	18
" sand	18	105
Blue clay, with sand streaks	105	400
Fine to better sand	400	468

WELL LOCATION:
sec. 31 T. 8 R. 14
4 miles South of Liln
(distance) (direction) (nearest town)

WELL PURPOSE: Office
(home, irrigation, municipal, industrial)

WELL COMPLETION DATA:

- (1) diameter (inches) 2"
- (2) total depth (feet) 468'
- (3) static water level (feet) flow below above top of ground.
- (4) casing galv. 4 1/2'
(material) (depth)
2"
(size) if telescope see back.
- (5) screen 5'
(length) (depth to top)
2" St. Steel
(size) (material)
- (6) pump 1/2 700 gphr.
(HP) (yield gpm)
electric
(type power)
- (7) electric log No.
(yes or no)

(organization running log)

(8) how well bottom plugged back
pressure valve

DRILLERS REMARKS:


CODED

JUN 14 1969

MISS. Bd. of
WATER COM.

If well telescopes please sketch and show depths.

GROUND LEVEL

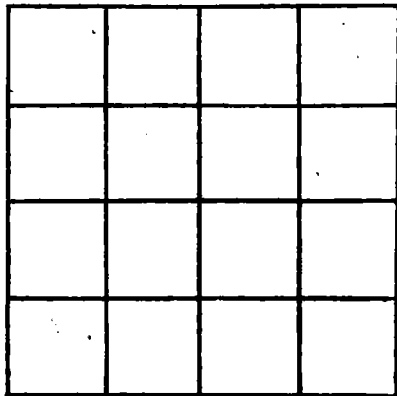

SECTION _____

Please indicate well location X.

ADDITIONAL INFORMATION

If more than one screen, show locations of each on sketch.