

**CODED**

MISSISSIPPI  
BOARD OF WATER COMMISSIONERS  
416 North State Street  
Jackson, Mississippi 39201

Jan 2/9/70  
Pint line 2/18/70

WATER WELL DRILLERS LOG

Hancock  
K 124  
1-19-70

Jan 19 1970 date well completed  
Fours well with Hancock firm name county well located

LANDOWNER: H. J. Starnes  
RT 3 Shreveport  
Dark Bay Bl. Louisiana  
Miss (mailing address)

WELL LOCATION:  
sec. 27 T. 4 S. R. 14 E. W. 1  
miles (distance) of (direction) (nearest town)

WELL PURPOSE: Pond  
(home, irrigation, municipal, industrial)

WELL COMPLETION DATA:  
(1) diameter (inches) 2  
(2) total depth (feet) 129  
(3) static water level (feet) 5 <sup>below</sup> top of ground  
(4) casing plastic, 129 (material) (depth)  
(size) if telescope see back.  
(5) screen 5', 129 (length) (depth to top)  
(size) 2 (material) plastic  
(6) pump plastic (material) install (type power)  
(7) electric log (yes or no)  
(organization running log)  
(8) how well bottom plugged B.W.U.

description of formations encountered	from	to
red clay	0	10
white & blue clay	10	20
white sand	20	30
" "	30	40
blue mud	40	50
blue mud & shells	50	60
" "	60	70
fine blue sand	70	80
soft blue mud	80	90
" " "	90	100
" " "	100	110
sand blue mud	100	110
sand blue loam	110	120
Work down about 8 ft in sand		


FEB 5 - 1970

MISS. BD. OF  
WATER COMM.

DRILLERS REMARKS:

If well telescopes please sketch and show depths.

GROUND LEVEL

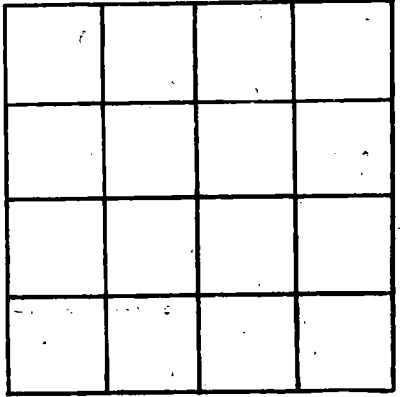

SECTION \_\_\_\_\_

Please indicate well location X.

ADDITIONAL INFORMATION

If more than one screen, show locations of each on sketch.