

Hancock
K 131
4-10-70

MISSISSIPPI
BOARD OF WATER COMMISSIONERS
416 North State Street
Jackson, Mississippi 39201
WATER WELL DRILLERS LOG

RECORDED

SUTTER WELL WORKS

Hancock

4-10 1970
date well completed

firm name

county well located

LANDOWNER: ROBT. PERKINS

description of formations encountered


from to

Box 4

CLERMONT HARBOR MISS.
(mailing address)

Clay	0	16
sand	16	47
Clay	47	85
sand	85	135
Clay	135	149
sand	149	173

WELL LOCATION: 024

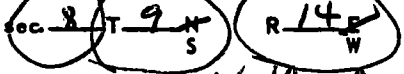

miles IN Waveland
(distance) (direction) of (nearest town)

WELL PURPOSE: home
(home, irrigation, municipal, industrial)

WELL COMPLETION DATA:

- (1) diameter (inches) 2
- (2) total depth (feet) 173'
- (3) static water level (feet) 13' below above top of ground.
- (4) casing Galv. 168' (material) (depth)
2" (size) if telescope see back.
- (5) screen 5' 168' (length) (depth to top)
2" (size) stainless steel (material)
- (6) pump 1 (HP) 15 (yield gpm)
elec (type power)
- (7) electric log no (yes or no)

~~Dratation Needed~~
5-12-70
JES

(organization running log)

(8) how well bottom plugged B.P. Valve

DRILLERS REMARKS:

MAY 4 1970

If well telescopes please sketch and show depths.

GROUND LEVEL

SECTION _____

Please indicate well location X.

ADDITIONAL INFORMATION

If more than one screen, show locations of each on sketch.