


If well telescopes please sketch and show depths.

GROUND LEVEL

84' of 4" casing

53' of 2" casing

2 x 10 screen

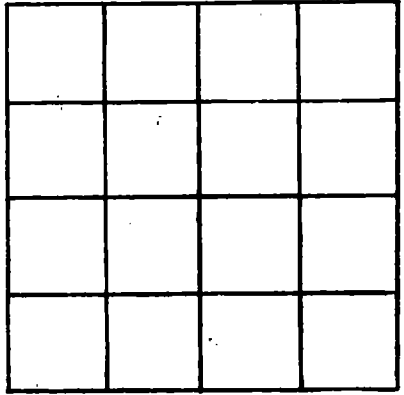

SECTION _____

Please indicate well location X.

ADDITIONAL INFORMATION

If more than one screen, show locations of each on sketch.