

Hancock Co
K 140
7-6-70

MISSISSIPPI
BOARD OF WATER COMMISSIONERS
416 North State Street
Jackson, Mississippi 39201

CODED

WATER WELL DRILLERS LOG

7-6 1970 To Neil Lumpkin Hancock
date well completed firm name county well located

LANDOWNER: <u>Ray Ladner</u>	description of formations encountered	from	to
<u>Bay St Louis</u> <u>Waveland Miss.</u> (mailing address)			
WELL LOCATION: sec. <u>8</u> T <u>9</u> R <u>14</u> (distance) miles (direction) (nearest town)	<u>Surface Clay</u>	<u>0</u>	<u>5</u>
WELL PURPOSE: <u>home</u> (home, irrigation, municipal, industrial)	<u>Sand & clay</u>	<u>5</u>	<u>60</u>
WELL COMPLETION DATA: (1) diameter (inches) <u>2"</u>	<u>Clay</u>	<u>60</u>	<u>100</u>
(2) total depth (feet) <u>1176'</u>	<u>Sand</u>	<u>100</u>	<u>132</u>
(3) static water level (feet) _____ below/above top of ground.	<u>Clay</u>	<u>132</u>	<u>250</u>
(4) casing <u>4 1/2"</u> (material) (depth)	<u>Good sand</u>	<u>250</u>	<u>330</u>
<u>2"</u> (size) If telescope see back.	<u>Clay</u>	<u>330</u>	<u>650</u>
(5) screen <u>21'</u> (length) (depth to top)	<u>Good sand</u>	<u>650</u>	<u>750</u>
<u>2"</u> (size) <u>St. Steel</u> (material)	<u>Clay</u>	<u>750</u>	<u>850</u>
(6) pump _____ (HP) _____ (yield gpm)	<u>good sand</u>	<u>850</u>	<u>945</u>
(type power) _____	<u>Clay</u>	<u>945</u>	<u>1000</u>
(7) electric log <u>no.</u> (yes or no)	<u>Good sand</u>	<u>1000</u>	<u>1176</u>
(organization running log) _____			
(8) how well bottom plugged <u>Johnson</u>			
<u>B.P. Vahn</u>			
DRILLERS REMARKS: <u>20 lbs. pressure</u>			


CODED

SEP 22 1970

MISS. BD. OF
WATER

If well telescopes please sketch and show depths.

GROUND LEVEL

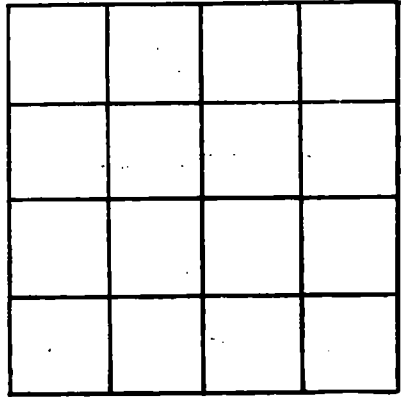

SECTION _____

Please indicate well location X.

ADDITIONAL INFORMATION

If more than one screen, show locations of each on sketch.