

Hancock
K142
5-20-70

MISSISSIPPI
 BOARD OF WATER COMMISSIONERS
 416 North State Street
 Jackson, Mississippi 39201

CODED

WATER WELL DRILLERS LOG

5-20 date well completed 1970 Penton Well Serv firm name Hancock county well located

LANDOWNER: J. A. Perrins
Shere Line Park
Bay St Louis Miss.
 (mailing address)

description of formations encountered	from to	
	feet	feet
Surface Clay	0	16
Muddy sand	16	85
Blue clay	85	120
Sand	120	126
Blue Clay	126	158
Grey sand	158	194

WELL LOCATION:
 sec. 40T-8 R. 14
2 miles North of Bay St Louis
 (distance) (direction) (nearest town)

WELL PURPOSE: None
 (home, irrigation, municipal, industrial)

WELL COMPLETION DATA:

(1) diameter (inches) 2

(2) total depth (feet) 194

(3) static water level (feet) 0 below above top of ground.

(4) casing Galv, 189,
 (material) (depth)
2 If telescope see back.
 (size)

(5) screen 5', 189
 (length) (depth to top)

012 2, 3. Steel
 (size) (material)

(6) pump ✓
 (HP) (yield gpm)

(type power)

(7) electric log No
 (yes or no)

(organization running log)

CODED

(8) how well bottom plugged B.W. Valve

JUN 16 1970


DRILLERS REMARKS:

MISS. BD. OF
 WATER COMM.

If well telescopes please sketch and show depths.

GROUND LEVEL

Shore Line Park

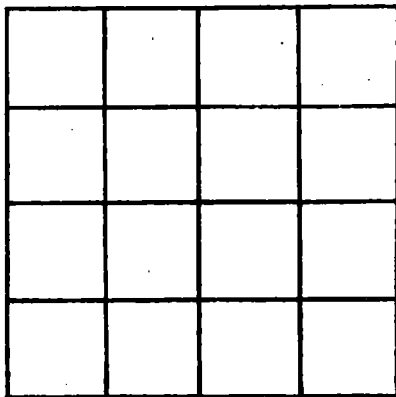

SECTION 40

Please indicate well location X.

ADDITIONAL INFORMATION

If more than one screen, show locations of each on sketch.