

HANCOCK
 K146
 7-23-70

MISSISSIPPI
 BOARD OF WATER COMMISSIONERS
 416 North State Street
 Jackson, Mississippi 39201

CODED

WATER WELL DRILLERS LOG

7-23 1970 Penton Well Serv Hancock
 date well completed firm name county well located

LANDOWNER: Charles Moran
 No #
Rt. 2, Box
Bay St. Louis Miss.
 (mailing address)

description of formations encountered	from	to
Surface Clay	0	18
Mixed Sand & Clay	18	95
Sand	95	120
Blue Clay	120	172
Sand	172	180
Blue Clay	180	225
Grey Sand	225	338
Blue Clay	338	387
Grey Sand	387	400
Blue Clay	400	860
Grey Sand	860	925

WELL LOCATION:
 sec. 7 T. 9 S. R. 14 W.
1 miles East of Lakeshore
 (distance) (direction) (nearest town)

WELL PURPOSE:
 (home, irrigation, municipal, industrial)

- WELL COMPLETION DATA:
- (1) diameter (inches) 2
 - (2) total depth (feet) 925
 - (3) static water level (feet) Flow ^{below} above top of ground.
 - (4) casing Black, 905,
 (material) (depth)
2 if telescope see back.
 (size)
 - (5) screen 20', 905,
 (length) (depth to top)
015 2", S. Steel
 (size) (material)
 - (6) pump NO,
 (HP) (yield gpm)
←
 (type power)
 - (7) electric log NO,
 (yes or no)
 - (organization running log)
 - (8) how well bottom plugged Bill. Valve


CODED

AUG 10 1970

DRILLERS REMARKS:

If well telescopes please sketch and show depths.

GROUND LEVEL

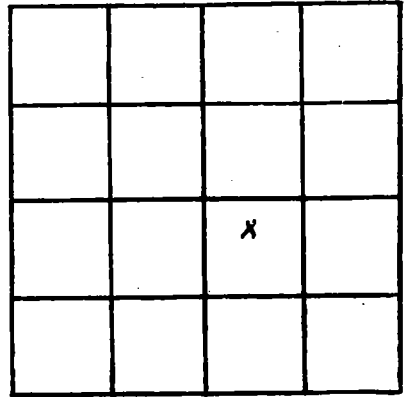

SECTION 7

Please indicate well location X.

ADDITIONAL INFORMATION

If more than one screen, show locations of each on sketch.