

HANCOCK
K 159
12-18-70

MISSISSIPPI
 BOARD OF WATER COMMISSIONERS
 416 North State Street
 Jackson, Mississippi 39201

CODED

WATER WELL DRILLERS LOG

12-18 1970 Pentoni Well Serv Hancock
 date well completed firm name county well located

LANDOWNER: Rodrick Hardie
Box 492
Bay St Louis Miss
 (mailing address)

WELL LOCATION:
 sec. 34 T 8 N R 14 E
 S W
 (distance) miles (direction) of (nearest town)

WELL PURPOSE:
 (home, irrigation, municipal, industrial)

WELL COMPLETION DATA: 4 1/2
 (1) diameter (inches) 2
 (2) total depth (feet) 1139
 (3) static water level (feet) 38 below above
 top of ground.
 (4) casing Black, 1119,
 (material) (depth)
2 If telescope see back.
 (size)
 (5) screen 20, 1119
 (length) (depth to top)
015 2", S. Steel
 (size) (material)
 (6) pump _____
 (HP) (yield gpm)
 (type power)
 (7) electric log NO
 (yes or no)
 (organization running log)
 (8) how well bottom plugged BW, Valve

| description of formations encountered | from | to |
|---------------------------------------|------|------|
| Surface Clay | 0 | 80 |
| Gravel | 80 | 138 |
| Blue Clay | 138 | 285 |
| Sand | 285 | 340 |
| Blue Clay | 340 | 385 |
| Sand | 385 | 418 |
| Blue Clay | 418 | 426 |
| Sand | 426 | 458 |
| Blue Clay | 458 | 560 |
| Sand | 560 | 610 |
| Blue Clay | 610 | 935 |
| Sand | 935 | 960 |
| Blue Clay | 960 | 1080 |
| Sand | 1080 | 1139 |

CODED


JAN 25 1971

MISS. BD. OF
 WATER COMM.

DRILLERS REMARKS:

If well telescopes please sketch and show depths.

GROUND LEVEL

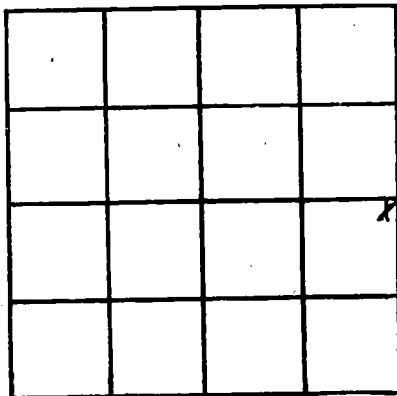

SECTION 34

Please indicate well location X.

ADDITIONAL INFORMATION

If more than one screen, show locations of each on sketch.