

HANCOCK

K166

2-9-71

MISSISSIPPI BOARD OF WATER COMMISSIONERS  
416 North State Street  
Jackson, Mississippi 39201

**CODED**

WATER WELL DRILLERS LOG

2-9  
date well completed

71 Penton Well Serv

firm name

Hancock  
county well located

LANDOWNER: ~~John~~ Bernos

Rt. 2 Box 415

Bay St Louis Miss  
(mailing address)

WELL LOCATION:

sec. 18 T 9 S R 14 W

0 miles East of Lakeshore  
(distance) (direction) (nearest town)

WELL PURPOSE: Home  
(home, irrigation, municipal, industrial)

WELL COMPLETION DATA:

- (1) diameter (inches) 2
- (2) total depth (feet) 325
- (3) static water level (feet) 3 below top of ground.
- (4) casing Galv 315 (material), (depth)

2 (size) if telescope see back.

- (5) screen 10' 315 (length), (depth to top)
- 2" stainless steel (size), (material)

- (6) pump 1/2 13 (HP), (yield gpm)
- Elec (type power)

- (7) electric log NO (yes or no)

(organization running log)

- (8) how well bottom plugged Bw. Valve

DRILLERS REMARKS:

description of formations encountered

from

Surface clay

16 16

Sand

16 22

Clay

22 30

Sand

30 52

Blue clay

52 75

Fine sand

75 115

Blue clay

115 285

Sand

285 325


**CODED**

MAR 9 1971

MISS. Bd. OF WATER COMM.

If well telescopes please sketch and show depths.

GROUND LEVEL

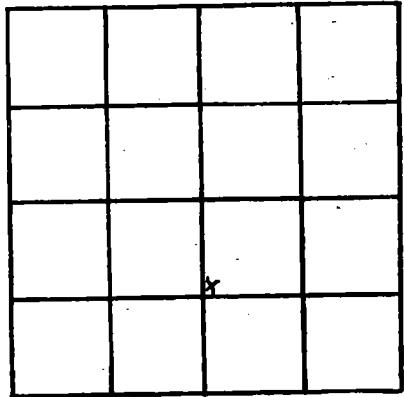

SECTION 18

Please indicate well location X.

ADDITIONAL INFORMATION

If more than one screen, show locations of each on sketch.